



ARCHITECTURE  
ENGINEERING  
CONSTRUCTION

8 RIDGEDALE AVENUE  
CEDAR KNOLLS, NJ 07927  
[www.eiassociates.com](http://www.eiassociates.com)

TELEPHONE (973) 775-7777  
FACSIMILE (973) 775-7770  
E-MAIL: [info@eiassociates.com](mailto:info@eiassociates.com)

**ADDENDUM NO. 1**

DATE: 24 March 2025

TO: All Plan Holders

PROJECT: Winslow HVAC Systems Upgrades – School #5 ES9782.01

BID NO.: 2025-07

INTENT: The purpose of this Addendum is to modify certain requirements of the Contract Documents which have been issued for BIDDING.

**I. PRE-BID MEETING MINUTES:**

Time: 2pm, 14 March 2025

Place: Winslow Board of Education Administration Building – Conference Room  
40 Cooper Folly Rd, Atco, NJ

Attendees:

NAME	COMPANY	EMAIL	PHONE NUMBER
Luis Rosario Project Manager	EI Associates	<a href="mailto:luis_rosario@eiassociates.com">luis_rosario@eiassociates.com</a>	Office: 973-775-7770 ext. 142 Cell: 917-518-5455
Connor Kennedy Mechanical Engineer	EI Associates	<a href="mailto:connor_kennedy@eiassociates.com">connor_kennedy@eiassociates.com</a>	Office: 973-775-7770 ext. 168
Tyra Boyle Business Administrator / Board Secretary	Winslow Twp School District	<a href="mailto:mccoity@winslow-schools.com">mccoity@winslow-schools.com</a>	Office: 856-767-2850 ext. 7510
Sandy Pinnock General Manager	Aramark Facilities Management	<a href="mailto:pinnock-sandy@aramark.com">pinnock-sandy@aramark.com</a>	Office: 856-767-0995 Cell: 856-617-2638

Plan holders as of 24 March 2025:

<u>Company</u>	<u>Name</u>	<u>Email</u>	<u>Fax</u>
Gaudelli Bros. Inc.	Angelo Gaudelli	<a href="mailto:ashley@gaudellibros.com">ashley@gaudellibros.com</a>	
Climatic	Frank Kohute	<a href="mailto:cmiller@climaticnj.com">cmiller@climaticnj.com</a>	
CGB	A. Piccone	<a href="mailto:apiccone@cgbmechanical.com">apiccone@cgbmechanical.com</a>	

**Discussion Items:**

Bid proposals are due to the Winslow Township School District, Administrative Office, 40 Cooper Folly Rd, Atco, NJ c/o Ms. Tyra Boyle, Business Administrator / Board Secretary on **Thursday April 3, 2025**. The bids must be delivered on that date by 10:00 am. The Board intends to award the contract on or about April 9, 2025.

1. Bids will be opened publically at 10:00 am. Bids received after 10:00 am will not be accepted.
2. Bidders must be classified and prequalified by the New Jersey Department of the Treasury prior to the time and date that bids are received:

General Contractor with a DPMC Classification of C008 General Construction, or  
General Contractor with a DPMC Classification of C009 General  
Construction/Alterations and Additions, or  
Mechanical Contractor with a DPMC Classification of C032 HVACR

Specialty Trades:

Structural Steel	C029
Plumbing	C030
HVACR	C032 (if C008 or C009 is Prime)
Electrical	C047

3. This project has one bid form which covers School #5.
4. All bidder's questions must be **in writing and emailed** to EI Associates, attention Luis Rosario, by 4pm March 20, 2025.  
**Email Address: [luis\\_rosario@eiassociates.com](mailto:luis_rosario@eiassociates.com)**
5. Addendum #1 will be issued by 4:00 pm on Monday, March 24, 2025.
6. Any substitutions for specified items shall be indicated on bid form attachment #14 during the bidding process. Substitutions will not be accepted after the bid.
7. The successful contractor shall provide a project schedule within seven calendar days after the award. Submittals and shop drawings are required within thirty days after the award.
8. The site will be available for construction on or about April 10, 2025. All work at each school must be substantially completed by **August 22, 2025**. Project final completion is required by **August 29, 2025**.
9. Abatement is not part of this contract. If hazardous materials are found, the District's representative will handle any required abatement.

General work:

1. All site arrangements shall be made thru the District's Head of Facilities Sandy Pinnock, cell 856-617-2638.
2. A site walk of each school will be conducted following this meeting, if anyone is interested. Anyone interested in visiting the sites at a later date will be required to arrange visits through the District. No one is to visit any school without prior authorization from the District.
3. **The District intends to make the building available to contractors during the school year after hours, weekend, and/or days school is closed AND must be coordinated with district 48 hours prior. The District intends to make the building site available to contractors from 7:30 am to 5:00 pm Monday thru Friday after June 24. Weekend work and after-hours work must be coordinated with the District 48 hours prior.**

Site:

4. Dumpster locations, Contractor parking, Contractor toilets/usage, site access at the school will be arranged with the Head of Facilities once a contractor is selected.
5. Contractor behavior: language, attire, radio, smoking, project cleanliness – this is a school that will be occupied to some extent during the course of construction.

Project Locations: School #5  
130 Oak Lead Road, Berlin, NJ 08009

**II. SUBMITTED QUESTIONS AND RESPONSES:**

1. ***Q: Verify fire alarm panel reprogramming is included in the bid.***

A: Contractor will be responsible for all fire alarm system updates (i.e. programming, confirm battery size, quantity of zonespower supplies, etc.)

2. ***Q: Will condensate be placed on the exterior walls using splash blocks?***

A: Condensate mains will be run in the interior of the building and dropped to a low point where a single penetration will be made. Here, low on the exterior wall, the condensate drain will be terminated to splash block. Unit Ventilators on first floor will have condensate drains through the back of the unit that penetrate low on exterior walls and terminate to splash block. Splash Blocks shall be concrete.

3. ***Q: Is insulation suitable for air conditioning for existing ducts to be re-used in GYM and Café?***

A: Contractor shall insulate/reinsulate all existing ductwork in unconditioned spaces and above ceilings. Exposed ductwork in conditioned spaces shall not be reinsulated.

**4. Q: Spec's say IT department will supply 2 drops to tie into the internet. 230900 Section 1.02 # 14**

A: Contractor needs to provide 2 supply drops for controls (cat 6 cable) to be web-based, coordinate with districts IT department

**5. Q: Will contractor be given VPN to controls?**

A: VPN will not be given to contractor. All controls work must be on-site.

**6. Q: Should solar be shown on single line to inform contractor?**

A: The solar will be added to the single line. See revised drawing E40.

**7. Q: RTU units, unit ventilators and VRF, DDC controllers from controllers, will we get the software required to access?**

A: RTU's have bacnet cards for BMS connection, VRF has controller gateway for BMS connection. Manufacturer software to be provided for trouble shooting. Add to contract: The contractor shall provide access tool to RTU's factory controllers. Basis of Design: Tracer TU tool by Trane, or approved equal.

**8. Q: New panel location takes space from storage areas off the stage.**

A: Panel will be relocated near existing panels in storage room.

**9. Q: Sheet #ED 11B - Remove 30KVA Transformer and Remove ATS (Why are these being removed)**

A: Equipment is to be left in existing condition and not removed.

**10. Q: Sheet #E 21 – Do not install battery backup light fixtures-This should be tied into**

*the generator.*

A: New light battery backed fixtures not purchased and fixtures added to KHP-Circuit 3.

**11. CHANGES TO SPECIFICATIONS:**

Revisions are shown in **red** below.

**SECTION – 230900**

1.02 SCOPE/SUMMARY

14. Contractor will provide two (2) cat-6 IP drops for integration into the Information Technology System. Coordinate with Districts' Information Technology Department.

**12. CHANGES TO DRAWINGS:**

**M01 General Demolition and New Work Notes**

**General Mechanical Notes – Note 46**

**ED11B Partial First Floor Demolition Power Plan**

**E11B Partial First Floor Power Plan**

**E21 Kitchen Demolition and New Lighting Plan**

**E40 New Electrical One-Line Diagram**

**E60 Fire Alarm Riser D**

Cc: All Bidders  
EI Distribution

**END OF ADDENDUM NO. 1**

**GENERAL MECHANICAL NOTES:**

1. THE PURPOSE OF THESE DRAWINGS IS TO INDICATE THE SCOPE OF THE NEW MECHANICAL WORK IN THIS AREA. ALL NEW WORK SHALL BE COORDINATED WITH ACTUAL FIELD CONDITIONS ENCOUNTERED.
2. THE CONTRACTOR SHALL PROVIDE ALL LABOR, EQUIPMENT AND MATERIALS FOR COMPLETE REMOVAL AND RELOCATION FOR THIS PROJECT.
3. ALL WORK SHALL CONFORM TO CODES AND THE REQUIREMENTS OF FEDERAL, STATE, AND LOCAL REGULATORY AGENCIES HAVING JURISDICTION.
4. ALL WORK SHALL BE PERFORMED IN ACCORDANCE WITH GOOD TRADE PRACTICE AND IN ACCORDANCE WITH APPLICABLE MANUFACTURER'S RECOMMENDATIONS.
5. THE CONTRACTOR SHALL VISIT THE SITE TO UNDERSTAND THE GENERAL NATURE AND COMPLEXITY OF THE PROJECT. THE CONTRACTOR IS RESPONSIBLE FOR ALL CONDITIONS AFFECTING THE WORK. IF THERE ARE ANY DISCREPANCIES OR QUESTIONS, THE CONTRACTOR SHALL BRING IT TO THE ENGINEER'S ATTENTION PRIOR TO BID AWARD.
6. WORK TO BE DONE SHALL BE INCLUSIVE. ANY WORK NOT SPECIFICALLY CALLED OR SHOWN FOR, BUT REASONABLY IMPLIED, INCLUDING CUTTING, PATCHING, PAINTING, RESTORATION OF EXISTING SURFACES TO REMAIN, AND REPAIR OF DAMAGES CAUSED DURING CONSTRUCTION SHALL BE PROVIDED BY THE CONTRACTOR.
7. THE CONTRACTOR IS RESPONSIBLE FOR COORDINATING ALL WORK WITH SUBCONTRACTORS DURING CONSTRUCTION.
8. EXISTING HVAC EQUIPMENT THAT INTERFERES WITH NEW ARRANGEMENT SHALL BE REMOVED, RE-INSTALLED, RELOCATED, RE-ROUTED, EXTENDED OR ABANDONED, AS REQUIRED, TO SUIT NEW ARRANGEMENT.
9. SHOULD REMOVAL, RELOCATION, OR REROUTING OF ANOTHER TRADES WORK BE REQUIRED TO ACCOMMODATE HVAC WORK, THE HVAC CONTRACTOR SHALL BE RESPONSIBLE FOR THAT WORK AND SHALL PAY ALL REQUIRED COSTS. WORK SHALL BE PERFORMED BY MECHANICS SKILLED IN THE PARTICULAR TRADE INVOLVED.
10. EXISTING EQUIPMENT, BUILDING AREA OR SURFACES DAMAGED SHALL BE REPLACED OR RESTORED TO ITS ORIGINAL CONDITION.
11. THE CONTRACTOR SHALL BE RESPONSIBLE FOR MAINTAINING THE INTEGRITY OF ALL STRUCTURAL ELEMENTS.
12. THE WORD "PROVIDE" MEANS TO FURNISH AND INSTALL.
13. (E) DESIGNATES EXISTING EQUIPMENT AND DEVICES THAT SHALL REMAIN.
14. GENERAL CONTRACTOR TO PROVIDE ALL NECESSARY SHORING AND BRACING SO AS NOT TO UNDERMINE EXISTING STRUCTURE. TAKE ALL NECESSARY MEASURES TO PREVENT COLLAPSE OF WALLS, SLABS, ETC.
15. EACH CONTRACTOR IS TO TAKE ALL NECESSARY MEASURES TO PREVENT DAMAGE TO ANY ADJACENT PROPERTY, PERSONS.
16. EACH CONTRACTOR IS TO COORDINATE ALL INDICATED DEMOLITION WITH NEW CONSTRUCTION TO ENSURE PROPER LOCATION AND DIMENSIONS OF DEMOLISHED AREAS.
17. DURING DEMOLITION AND REMOVAL, THE CONTRACTOR SHALL NOTIFY THE ARCHITECT, IN WRITING, OF ANY UNEXPECTED OR UNUSUAL CONDITIONS.
18. CUTTING SHALL BE PERFORMED BY HAND OR SMALL POWER TOOLS; HOLES AND SLOTS CUT NEAT AND TO SIZE REQUIRED, WITH MINIMUM DISTURBANCE OF ADJACENT WORK; CUT HOLES IN CONCRETE FOR PIPES AND CONDUIT WITH CORE DRILLS OF PROPER SIZES. OPENINGS SHALL BE COVERED TEMPORARILY WHEN NOT IN USE AND PATCHED AS SOON AS WORK IS INSTALLED.
19. PATCH AND PAINT ALL SURFACES DAMAGED BY DEMOLITION OR INSTALLATION OF NEW WORK TO MATCH ADJACENT AREAS.
20. REPAINTING OF AFFECTED AREAS OR SURFACES SHALL MATCH COLOR AND TEXTURE OF EXISTING PAINTED SURFACES, UNLESS OTHERWISE INDICATED.
21. FILL IN ALL HOLES IN EXISTING TILE, GLAZED BLOCK WALLS, OR TERRAZZO FLOORING RESULTING FROM EXISTING EQUIPMENT REMOVAL WITH EPOXY PUTTY - A+B EPOXY PUTTY BY REZOLIN, LLC. OR EQUAL - SMOOTH AND PAINT TO MATCH EXISTING FINISH.
22. REINSTALL ACOUSTICAL CEILING TILES AND GRID SYSTEM MEMBERS TO MATCH AREAS NOT REMOVED DURING DEMOLITION. REUSE STORED TILES AND GRID SYSTEM AS MUCH AS POSSIBLE. PROVIDE NEW MEMBERS WHEREVER NECESSARY TO MATCH EXISTING.
23. ALL EXPOSED PIPING SHALL BE PROVIDED WITH PVC JACKET OVER INSULATION.
24. ALL THERMOSTATS LOCATED IN GYMS, AUDITORIUM, HALLWAYS OR OTHER PUBLIC AREAS SHALL BE PROVIDED WITH PROTECTIVE COVER GUARD.
25. THE CONTRACTOR SHALL PROVIDE ALL ADDITIONAL LABOR AND MATERIALS TO PROPERLY BALANCE ALL MOTORS AND FANS IN RTU'S AS REQUIRED TO BALANCE FANS TO AIR FLOW RATES SHOWN ON CONTRACT DOCUMENTS.
26. THE CONTRACTOR SHALL FIELD VERIFY EXISTING VOLTAGES AND PHASES OF ALL EQUIPMENT TO BE REPLACED THAT WILL BE REUSING EXISTING CIRCUITS PRIOR TO PROVIDING EQUIPMENT SUBMITTALS, RELEASE FOR FABRICATION AND PURCHASING OF EQUIPMENT. IF NEW EQUIPMENT IS PURCHASED PRIOR TO CONFIRMING EXISTING CIRCUIT VOLTAGES AND PHASES, THE CONTRACTOR SHALL BE RESPONSIBLE FOR THE ANY ADDITIONAL COSTS AND EXPENSES ASSOCIATED WITH NEW CIRCUITING AND/OR PURCHASE OF NEW EQUIPMENT.
27. THE CONTRACTOR SHALL COORDINATE AND INSTALL ALL NEW ROOF TOP EQUIPMENT WITH EXISTING AND NEW STRUCTURAL MEMBERS. SEE STRUCTURAL DRAWINGS AND ACTUAL FIELD CONDITIONS. PROVIDE ALL ADDITIONAL REQUIRED STRUCTURAL SUPPORTS, HARDWARE AND ASSOCIATED APPURTENANCES.
28. THE CONTRACTOR SHALL PROVIDE ISOLATION BETWEEN ALL DISSIMILAR METALS AND MATERIALS.
29. VERIFY ALL EXISTING PIPE SIZES WHERE NEW PIPES ARE TO BE RECONNECTED TO EXISTING PRIOR TO CONSTRUCTION AND PROVIDE NEW PIPES OF SIZES TO MATCH EXISTING.
30. PROVIDE ISOLATION VALVES FOR PIPING AT ALL NEW EQUIPMENT. ISOLATION VALVES SHALL BE SAME SIZE AS LINE SERVED. SEE SPECIFICATIONS FOR ADDITIONAL REQUIREMENTS.
31. COORDINATE ALL EQUIPMENT AND CONTROLS WITH THE ATC CONTRACTOR.
32. ALL NEW THERMOSTATS AND SPACE TEMPERATURE SENSORS SHALL BE MOUNTED IN ACCORDANCE WITH ADA HEIGHT REQUIREMENTS.
33. MOTORS FOR FANS EQUAL TO OR GREATER THAN 1/12 HP AND LESS THAN 1 HP SHALL BE ELECTRONICALLY-COMMUTATED MOTORS OR HAVE A MINIMUM EFFICIENCY OF 70%. THESE MOTORS SHALL ALSO BE SPEED ADJUSTABLE FOR EITHER BALANCING OR REMOTE CONTROL.
34. PROVIDE BALANCING VALVES / CIRCUIT SETTERS ON ALL NEW EQUIPMENT AS REQUIRED TO PROPERLY BALANCE EQUIPMENT.
35. PROVIDE ALL NEW AIR BALANCING DAMPERS, WHERE MISSING, ON NEW AND EXISTING DUCTWORK, AS REQUIRED TO PROPERLY BALANCE AIRSIDE SYSTEMS.
36. MAINTAIN ALL FIRE RATED PARTITIONS. PROVIDE FIRE DAMPERS, FIRE SEALANT, ETC. AS REQUIRED.
37. CONTRACTOR RESPONSIBLE FOR ALL REQUIRED DRAINING AND REFILLING OF SYSTEMS TO FACILITATE WORK.
38. CONTRACTOR SHALL FIELD VERIFY ALL EXISTING LOCATIONS AND SIZES OF PIPING AND DUCT SYSTEMS TO RECONNECT TO. CONTRACTOR SHALL PROVIDE ALL REQUIRED ADDITIONAL ELBOWS, TRANSITIONS, PIPING, DUCTWORK, SUPPORTS, MATERIALS AND LABOR AS REQUIRED FOR A COMPLETE AND FUNCTIONAL INSTALLATION.
39. PROVIDE SLEEVES ON ALL PENETRATIONS EXCEPT FOR CORE DRILLS THROUGH SOLID MASONRY WALLS. PROVIDE ESCUTCHEON COVERS AS REQUIRED.
40. CONCEAL PIPING ABOVE CEILINGS, IN SOFFITS, AND CHASES TO THE GREATEST EXTENT POSSIBLE. EXPOSED REFRIGERANT PIPING SHALL BE CONCEALED IN LINESET COVERS.
41. CONDENSATE PIPING SHALL BE PITCHED A MINIMUM OF 1/8" PER FOOT.
42. PENETRATIONS BETWEEN 1ST AND 2ND FLOOR. THE CONTRACTOR SHALL REMOVE EXISTING CEILING TILES, SUPPORT TRACKS, INTERMEDIATE SHEATING, PLASTER SUBSTRATE AND LATH TO BE REMOVED AS REQUIRED TO FACILITATE WORK. EXISTING SUSPENDED PLASTER CEILING SUPPORT TO REMAIN. INCLUDING PRIMARY AND SECONDARY CEILING CHANNELS AND VERTICAL SUPPORT STRAPS.
43. CONDUCTED A THOROUGH INSPECTION OF ALL ACCESSIBLE DUCTWORK FOR DUST, DEBRIS, AND BUILDUP. UTILIZED PROFESSIONAL-GRADE VACUUM EQUIPMENT AND ROTARY BRUSHES TO CLEAN DUCT INTERIORS. CLEANED REGISTERS, GRILLES, AND DIFFUSERS TO REMOVE VISIBLE DIRT AND CONTAMINANTS. VERIFIED AIRFLOW AND CHECKED FOR BLOCKAGES TO ENSURE OPTIMAL HVAC PERFORMANCE POST-CLEANING. APPLIED AN ANTIMICROBIAL TREATMENT (IF APPLICABLE) TO INHIBIT MOLD AND BACTERIA GROWTH.
44. CONDUCTED AN INSPECTION OF THE PIPING SYSTEM FOR SIGNS OF DEBRIS, BLOCKAGES, OR BUILDUP. UTILIZED APPROPRIATE CLEANING METHODS (E.G., FLUSHING, PRESSURE CLEANING, OR CHEMICAL TREATMENTS) TO REMOVE OBSTRUCTIONS AND DEPOSITS. ENSURED THAT ALL CLEANING AGENTS USED WERE COMPATIBLE WITH THE PIPE MATERIAL TO PREVENT DAMAGE. CHECKED FOR CORROSION, LEAKS, OR WEAR DURING THE CLEANING PROCESS AND DOCUMENTED ANY FINDINGS FOR FURTHER ACTION. RESTORED SYSTEM OPERATION AND VERIFIED PROPER FLOW AND PRESSURE LEVELS POST-CLEANING. PROVIDED RECOMMENDATIONS FOR ROUTINE MAINTENANCE TO PREVENT FUTURE ISSUES.
45. CONTRACTOR TO PROVIDE CLEANING OF EXISTING DUCTWORK, IMPROVE AIR QUALITY, ENHANCE HVAC EFFICIENCY, AND REDUCE ALLERGENS. BEFORE CLEANING, INSPECT DUST, MOLD, AND LEAKS. USE A HEPA VACUUM, BRUSHES, AND COMPRESSED AIR TO REMOVE DEBRIS. CLEAN VENTS, REGISTERS, AND HVAC COMPONENTS. SANITIZE WITH EPA-APPROVED PRODUCTS.
46. CONTRACTOR TO PROVIDE EXISTING PIPE CLEANING: INSPECTION OF THE PIPES FOR DIRT, BLOCKAGES, OR DAMAGE. TURN OFF AND DRAIN THE SYSTEM BEFORE CLEANING. USE WATER, AIR, CHEMICALS, OR CLEANING TOOLS TO REMOVE DEBRIS. WEAR SAFETY GEAR AND FOLLOW PRECAUTIONS. CHECK THE PIPES AFTER CLEANING TO ENSURE THEY ARE CLEAR. RESTORE THE SYSTEM AND TEST IT BEFORE USE.
46. CONTRACTOR TO PROVIDE NEW INSULATION FOR EXISTING DUCTWORK TO REMAIN IN UNCONDITIONED SPACES.

**GENERAL DEMOLITION NOTES:**

1. THE PURPOSE OF THESE DRAWINGS IS TO INDICATE THE SCOPE OF THE MECHANICAL DEMOLITION WORK TO PERMIT THE INSTALLATION OF NEW WORK. COORDINATE DEMOLITION WORK WITH BOTH NEW WORK AND THE ACTUAL FIELD CONDITIONS ENCOUNTERED.
2. THE CONTRACTOR SHALL BE RESPONSIBLE FOR THE SITE REMOVAL OF THOSE MATERIALS NOT INTENDED FOR REUSE AND FOR PROPER DISPOSAL OF MATERIALS.
3. THE CONTRACTOR SHALL REMOVE ALL EXISTING HEATING HOT WATER PIPING, VALVES, AND CONTROLS, AND ASSOCIATED APPURTENANCES AS INDICATED ON PLANS OR AS REQUIRED TO FACILITATE WORK. THIS INCLUDES ALL HWS AND HWR PIPING EXPOSED AND ABOVE CEILINGS.
4. EXISTING EQUIPMENT AND MATERIALS NOT DESIRED BY THE OWNER SHALL BECOME THE PROPERTY OF THE CONTRACTOR AND SHALL BE PROMPTLY REMOVED FROM THE SITE. EQUIPMENT AND MATERIALS DESIRED BY THE OWNER SHALL BE DELIVERED BY THE CONTRACTOR TO THE LOCATION DESIGNATED BY THE OWNER.
5. EXISTING MECHANICAL WORK THAT IS TO REMAIN WHEN EXISTING STRUCTURE ON WHICH IT IS INSTALLED IS TO BE MODIFIED OR REMOVED SHALL BE PROPERLY SUPPORTED UNLESS WORK OF ALL TRADES IS COMPLETE. REINSTALL THE HVAC WORK ON NEW STRUCTURE, AS REQUIRED.
6. PATCH EXISTING FINISHED SURFACES AND BUILDING COMPONENTS USING NEW MATERIALS MATCHING EXISTING MATERIALS IN LOCATIONS WHERE EXISTING EQUIPMENT WAS REMOVED, OR REMOVED AND REPLACED WITH NEW EQUIPMENT WHICH HAS DIFFERENT DIMENSIONS THAN THE REMOVED EQUIPMENT.
7. CONTRACTOR SHALL VERIFY AND IDENTIFY THE EXISTING PIPING SERVICES BEFORE REMOVAL TO AVOID REMOVAL OF ANY PIPING SERVICES REQUIRED TO REMAIN.
8. THE PIPING & DUCTWORK SHOWN ARE DIAGRAMMATIC ONLY. ADDITIONAL PIPING AND PIPING DEVICES (I.E. VALVES, ELBOWS ETC.) NOT SHOWN ON THE DRAWINGS EXIST AND SHALL BE REMOVED AT NO ADDITIONAL COST TO THE OWNER.
9. NO SYSTEM, NATURAL GAS (SHOWN ON PLUMBING DRAWINGS), WATER OR ELECTRICAL SHALL BE SHUTDOWN WITHOUT PRIOR REVIEW WITH THE OWNERS PROJECT MANAGER TO CONFIRM THAT AREAS TO REMAIN IN OPERATION CAN BE AFFECTED BY A SHUTDOWN. SUFFICIENT ADVANCE NOTICE MUST BE GIVEN TO THE OWNERS PROJECT MANAGER INDICATING WHEN THE PROPOSED SHUTDOWN WILL OCCUR, AND FOR HOW LONG A PERIOD OF TIME. INTENT OF ANY SHUTDOWN NOTIFICATION MUST BE GIVEN 72 HOURS PRIOR TO SHUTDOWN.
10. EXISTING CEILINGS ARE LAY-IN TYPE UNLESS OTHERWISE NOTED. REMOVE AS REQUIRED TO COMPLETE WORK. REINSTALL TILES AFTER WORK HAS BEEN COMPLETED. REFER TO ARCHITECTURAL DRAWINGS FOR ADDITIONAL INFORMATION.
11. ALL EXISTING DOORS WITH TRANSFER AIR GRILLES SHALL REMAIN UNLESS OTHERWISE NOTED.
12. (E) DESIGNATES EXISTING EQUIPMENT AND DEVICES THAT SHALL REMAIN.
13. (R) DESIGNATES EXISTING EQUIPMENT AND DEVICES THAT SHALL BE DEMOLISHED AND REMOVED.
14. ALL CONTROLS DEMOLITION SHALL BE CAREFULLY COORDINATED WITH THE ATC CONTRACTOR.
15. DEMOLISHED EQUIPMENT SHALL BE REMOVED FROM THE BMS AS APPLICABLE.
16. WHERE THERMOSTATS ARE DEMOLISHED, PATCH AND PAINT WALL TO MATCH EXISTING.

**CONSTRUCTION DEMOLITION NOTES:**

1. REMOVE AND STORE FOR FUTURE RE-INSTALLATION ALL ACOUSTICAL CEILING TILES AND GRID SYSTEM MEMBERS WHEREVER NECESSARY IN ORDER TO FACILITATE DEMOLITION AND NEW WORK. REPLACE ALL CEILING TILES AND GRID SYSTEM DAMAGED DURING REMOVAL, DEMOLITION, NEW WORK AND RE-INSTALLATION TO MATCH EXISTING.
2. REMOVE ANY LOOSE OR DAMAGED PAINT OR, IF NECESSARY, PLASTER LOCATED BEHIND ANY EXISTING RADIATORS OR OTHER EQUIPMENT BEING REMOVED. PATCH AND PAINT TO MATCH EXISTING ADJACENT WALL SURFACES.
3. REMOVE ANY LOOSE OR DAMAGED FLOOR TILES LOCATED BELOW OR ADJACENT TO EQUIPMENT BEING REMOVED. PATCH WITH VINYL TILES TO MATCH EXISTING FLOOR.
4. REMOVE AND DISCARD ALL EXISTING BLOCKING USED TO SUPPORT EXISTING EQUIPMENT WHICH WILL NO LONGER BE REQUIRED FOR THE NEW EQUIPMENT BEING INSTALLED.
5. CONTRACTOR SHALL BE RESPONSIBLE FOR PROVIDING ALL REQUIRED LINTELS FOR NEW WALL OPENINGS.

**ROOF WARRANTY:**

WHERE CONTRACTOR'S WORK REQUIRES DISTURBING OF THE EXISTING ROOF THE CONTRACTOR SHALL, PRIOR TO BEGINNING ANY WORK, CONFIRM WITH THE OWNER'S REPRESENTATIVE IF THE EXISTING ROOF IS UNDER MANUFACTURER WARRANTY.

A) IF THE EXISTING ROOF SYSTEM IS PRESENTLY UNDER A MANUFACTURER'S WARRANTY, THEN ALL WORK SHALL BE PERFORMED BY AN INSTALLER CERTIFIED BY THE EXISTING ROOFING MANUFACTURER. ANY MODIFICATIONS TO THE EXISTING ROOFING SYSTEM SHALL BE PERFORMED AS PER THE ROOFING MANUFACTURER'S REQUIREMENTS AND MUST MEET THE NECESSARY MANUFACTURER'S CRITERIA IN ORDER TO MAINTAIN THE PRESENT WARRANTY. CONTRACTOR SHALL PROVIDE ALL PROVISIONS NECESSARY FOR THE PROTECTION OF EXISTING EXPOSED SURFACES FROM PERIODS OF RAINFALL TO AVOID DAMAGE TO EXISTING STRUCTURE AND EXISTING/NEW ROOFING SURFACES IF RAINFALL SHALL OCCUR.


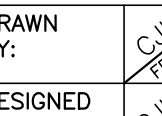

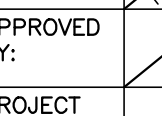
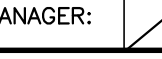
B) IF THE EXISTING ROOF IS NOT UNDER MANUFACTURER'S WARRANTY, THEN ALL NEW ROOF WORK, INCLUDING ALL NEW ROOF PENETRATIONS, CURBS, ROOF MOUNTED EQUIPMENT, WALKING PADS AND CRICKETS, MUST BE PERFORMED TO PROTECT AND LIMIT DAMAGE TO THE EXISTING STRUCTURE AND ROOF. CONTRACTOR SHALL MAKE PROVISIONS (PROTECTION OF EXISTING EXPOSED SURFACES) FOR PERIODS OF RAINFALL DURING THE ROOFTOP INSTALLATION TO AVOID DAMAGES TO EXISTING STRUCTURE AND ROOFING SURFACES IF RAINFALL SHALL OCCUR.


**HAZARDOUS MATERIALS:**

HAZARDOUS MATERIALS SUCH AS ASBESTOS EXIST ON THIS PROJECT. NO DEMOLITION SHALL TAKE PLACE UNTIL TESTING AND ABATEMENT OF HAZARDOUS MATERIALS IS COMPLETED BY THE ABATEMENT CONTRACTOR. THE MECHANICAL CONTRACTOR SHALL COORDINATE WITH ABATEMENT CONTRACTOR THE EXTENT OF REQUIRED DEMOLITION.

**REFRIGERANT DISPOSAL:**

WHERE EXISTING REFRIGERANT EQUIPMENT IS DEMOLISHED. THE CONTRACTOR SHALL EVACUATE AND DISPOSE OF REFRIGERANT IN ACCORDANCE WITH EPA GUIDELINES & REQUIREMENTS.

NJDOE STATE PROJECT NO.: TBD			
1	ISSUED FOR ADDENDUM 1	LR	24 MAR 25
0	ISSUED FOR BID CONSTRUCTION	LR	14 FEB 25
REV	REVISION DESCRIPTION	BY	DATE
 <b>EI Associates</b> ARCHITECTURE & ENGINEERS, PA 8 RIDGEDALE AVENUE • CEDAR KNOLLS NJ 07927 • 973.775.7777		ADAM CARAVAGLIA, P.E.      PROFESSIONAL ENGINEER LICENSE NO. NJ G52859      MECHANICAL	
SCALE	AS NOTED	PROJECT	EIA DRAWING NO.
DRAWN BY:		<b>WINSLOW TOWNSHIP SCHOOL DISTRICT HVAC SYSTEM UPGRADES AT SCHOOL #5</b> WINSLOW      NEW JERSEY	<b>M01</b>
DESIGNED BY:			
CHECKED BY:			
APPROVED BY:			
PROJECT MANAGER:		TITLE	CLIENT DWG. NO. - - - - - EIA PROJECT NO. ES9782.01
		<b>GENERAL DEMOLITION AND NEW WORK NOTES</b>	

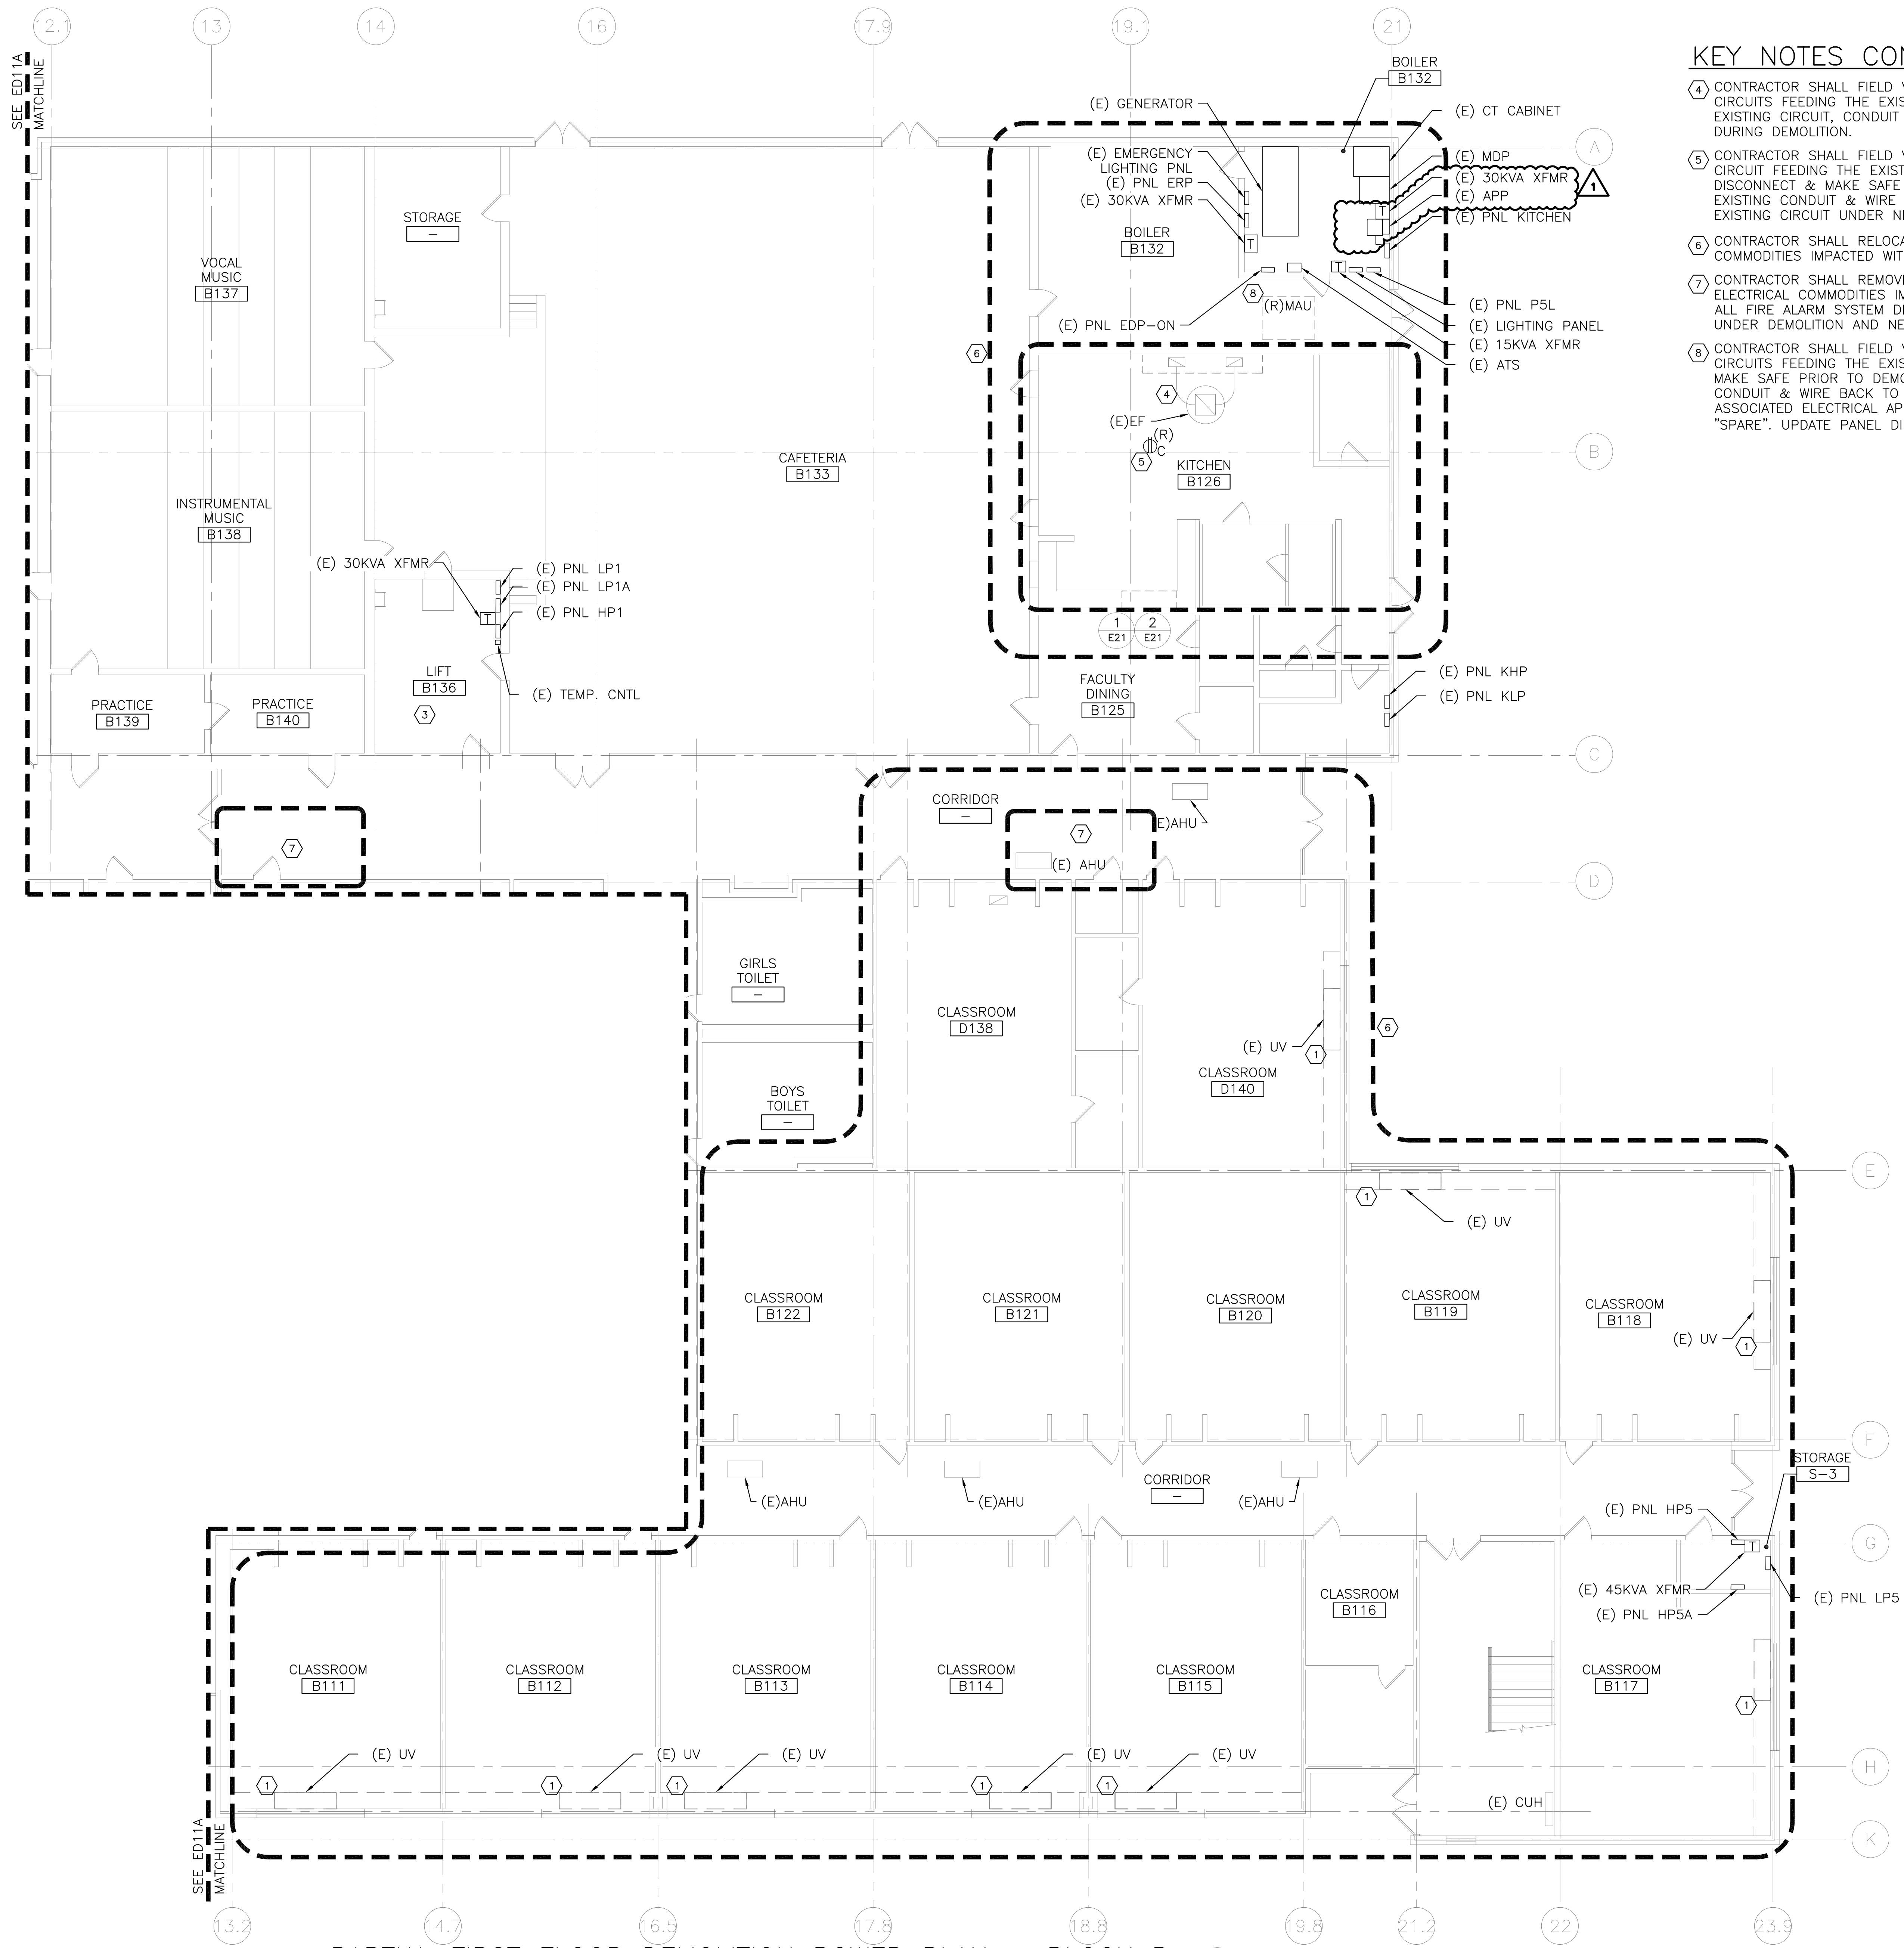

PARTIAL FIRST FLOOR DEMOLITION POWER PLAN - BLOCK B  
 1/8" = 1'-0" (1 ED11B)

**KEY NOTES CONT:**



- 4. CONTRACTOR SHALL FIELD VERIFY, CONFIRM THE EXISTING CIRCUITS FEEDING THE EXISTING EXHAUST FAN & MAKE SAFE. EXISTING CIRCUIT, CONDUIT & WIRE SHALL BE PROTECTED DURING DEMOLITION.
- 5. CONTRACTOR SHALL FIELD VERIFY, CONFIRM THE EXISTING CIRCUIT FEEDING THE EXISTING CEILING MOUNTED RECEPTACLE, DISCONNECT & MAKE SAFE PRIOR TO DEMOLITION. DEMOLISH EXISTING CONDUIT & WIRE BACK TO SOURCE PANEL. RE-USE EXISTING CIRCUIT UNDER NEW WORK. REFER TO E11B.
- 6. CONTRACTOR SHALL RELOCATE ANY/ALL ELECTRICAL COMMODITIES IMPACTED WITHIN SCOPE OF WORK AREA.
- 7. CONTRACTOR SHALL REMOVE, REINSTALL AND RELOCATE ANY ELECTRICAL COMMODITIES IMPACTED BY STRUCTURAL WORK. ALL FIRE ALARM SYSTEM DEVICES SHALL REMAIN ACTIVE UNDER DEMOLITION AND NEW WORK.
- 8. CONTRACTOR SHALL FIELD VERIFY, CONFIRM THE EXISTING CIRCUITS FEEDING THE EXISTING MUA UNIT, DISCONNECT & MAKE SAFE PRIOR TO DEMOLITION. DEMOLISH EXISTING CONDUIT & WIRE BACK TO SOURCE PANEL AS WELL AS ALL ASSOCIATED ELECTRICAL APPURTENANCES. TAG BREAKER "SPARE". UPDATE PANEL DIRECTORY FOR THIS WORK.

**DEMOLITION NOTES:**

- 1. REFER TO DRAWING NUMBER E00 FOR GENERAL NOTES, ABBREVIATIONS, SYMBOLS AND DEMOLITION NOTES.
- 2. THE CONTRACTOR SHALL FIELD VERIFY EXISTING BRANCH CIRCUITS AND FEEDERS PRIOR TO START OF DEMOLITION. BRANCH CIRCUITS AND FEEDERS AFFECTED BY RENOVATION AND DEMOLITION WORK SHALL BE RE-ROUTED, EXTENDED AND/OR REWIRED AS REQUIRED FOR NEW CONSTRUCTION.
- 3. THE CONTRACTOR SHALL WIRE AND RELOCATE EXISTING ELECTRICAL EQUIPMENT INDICATED ON THE PLANS. REFER TO DEMOLITION NOTES FOR OTHER ELECTRICAL SYSTEMS EXTENT OF WORK IN DEMOLITION AND RENOVATED AREAS. COMPLY WITH CODES AND STANDARDS.
- 4. UTILIZE AND RELOCATE AS INDICATED ON DRAWINGS FIRE ALARM DEVICES, SPEAKERS, CLOCKS, INTRUSION DETECTION DEVICES, WIRING DEVICES ETC. AFFECTED BY RENOVATION WORK.
- 5. CIRCUIT BREAKERS BEING MADE SPARE BY REMOVALS IN DEMOLISHED AND RENOVATED AREAS MAY BE RE-USED FOR NEW WORK WHEN NO OTHER CIRCUITS IN THE PANEL ARE AVAILABLE. THE CONTRACTOR SHALL DETERMINE ACCURATE EXISTING CIRCUITING ARRANGEMENTS IN THE FIELD AND UPDATE PANEL DIRECTORIES (TYPE WRITTEN) THAT ARE BEING AFFECTED BY THIS WORK. EXISTING 15A AND 20A CIRCUITS UTILIZED SHALL NOT EXCEED TOTAL CONNECTED LOAD OF 10 AMPS AND 14 AMPS AT 120V PER CIRCUIT, RESPECTIVELY.
- 6. REFER TO MECHANICAL DEMOLITION PLANS FOR MECHANICAL EQUIPMENT TO BE REMOVED. THE CONTRACTOR SHALL REMOVE POWER WIRING, CONDUIT, AND CONNECTIONS FROM EQUIPMENT SHOWN TO BE REMOVED ON MECHANICAL PLANS AND SCHEDULE OUTAGE OF MECHANICAL EQUIPMENT.
- 7. ALL EXISTING ELECTRICAL EQUIPMENT SHOWN OR NOT, THAT IS NOT AFFECTED BY DEMOLITION AND RENOVATION SHALL REMAIN, AND BE COVERED AND PROTECTED DURING CONSTRUCTION. USE UL APPROVED AND LISTED COVERS FOR FIRE ALARM DEVICES.
- 8. WHETHER SHOWN OR NOT ON THE DEMOLITION PLANS, THE CONTRACTOR IS REQUIRED TO REMOVE, RELOCATE, RECONNECT, AND/OR REWIRE ALL ELECTRICAL, AUXILIARY SYSTEMS AND ASSOCIATED EQUIPMENT AFFECTED BY DEMOLITION, INCLUDING ABANDONED CABLES.
- 9. ELECTRICAL EQUIPMENT AND WIRING TO BE REMOVED IN RENOVATED AND AFFECTED AREAS IS NOT ALL SHOWN ON THIS DRAWING. IT IS THE CONTRACTOR'S RESPONSIBILITY TO IDENTIFY, CONFIRM AND COORDINATE WITH THE OWNER. THERE WILL BE NO EXTRA COST TO THE OWNER FOR ANY MISSED EQUIPMENT AND WIRING TO BE REMOVED.

**KEY NOTES:**

- 1. CONTRACTOR SHALL FIELD VERIFY, CONFIRM THE EXISTING CIRCUITS FEEDING THE EXISTING UNIT VENTILATORS, DISCONNECT & MAKE SAFE PRIOR TO DEMOLITION. DEMOLISH EXISTING CONDUIT AND WIRE BACK TO SOURCE PANEL. ELECTRICAL CONTRACTOR DISCONNECT POWER FROM NEEDLE POINT IONIZATION AND MECHANICAL CONTRACTOR SHALL REINSTALL UNDER NEW WORK. RE-USE ASSOCIATED CIRCUIT FOR NEW WORK. REFER TO E10.
- 2. NOT USED
- 3. CONTRACTOR SHALL RELOCATE EXISTING FURNITURE TO MAKE ROOM FOR NEW ELECTRICAL PANELS UNDER NEW WORK. REFER TO E11B.

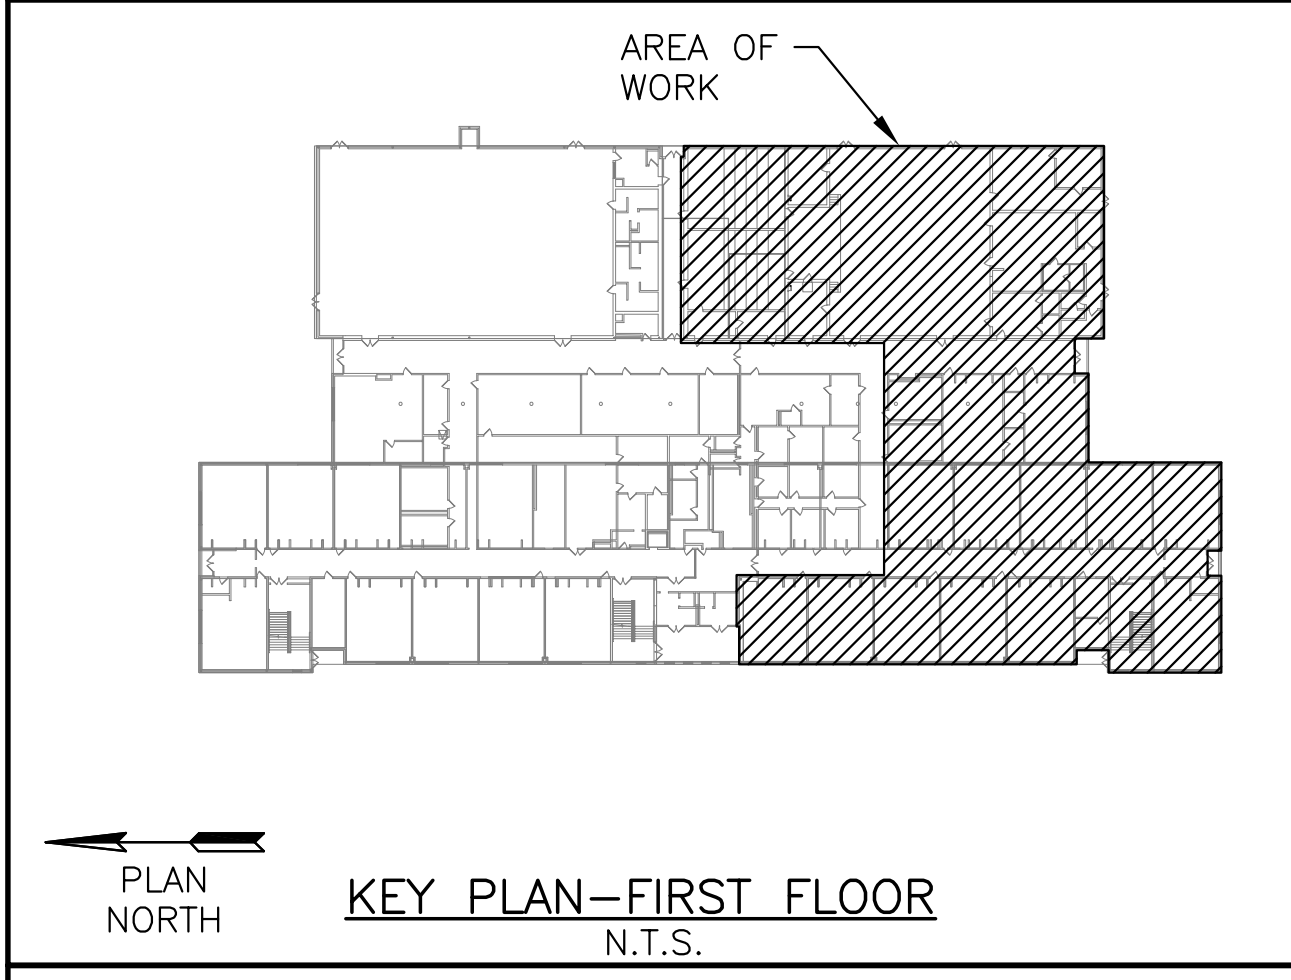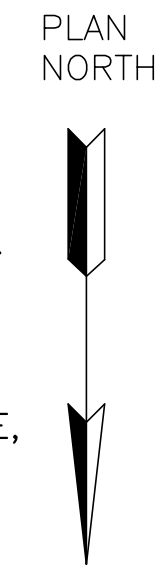


REV	REVISION DESCRIPTION	BY	DATE
1	ISSUED FOR ADDENDUM 1	LR	24 MAR 25
0	ISSUED FOR BID AND CONSTRUCTION	LR	14 FEB 25

**EI Associates**  
 ARCHITECTS & ENGINEERS, PA  
 8 RIDGEDALE AVENUE CEDAR KNOLLS NJ 07927-973.775.7777

BRIAN C. HARTZEL, P.E. PROFESSIONAL ENGINEER LICENSE NO. NJ GE58995 ELECTRICAL

SCALE AS NOTED	PROJECT	EIA DRAWING NO.
DRAWN BY: [Signature]	WINSLOW TOWNSHIP SCHOOL DISTRICT	ED11B
DESIGNED BY: [Signature]	HVAC SYSTEM UPGRADES AT SCHOOL #5	CLIENT DWG. NO. -----
CHECKED BY: [Signature]	WINSLOW NEW JERSEY	EIA PROJECT NO. ES9782.01
APPROVED BY: [Signature]	TITLE	
PROJECT MANAGER:	PARITAL FIRST FLOOR DEMOLITION POWER PLAN	

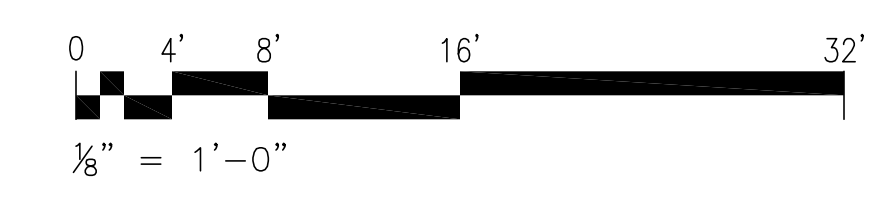

**GENERAL NOTES:**



- REFER TO DRAWING E00 FOR ABBREVIATIONS, LEGENDS, SYMBOLS, GENERAL NOTES, CONDUIT & WIRE NOTES, DEMOLITION NOTES.
- REFER TO DRAWING E40 FOR ELECTRICAL SINGLE LINE.
- REFER TO DRAWING E50 FOR PANEL SCHEDULES AND CIRCUIT INFORMATION.
- COORDINATE ALL ELECTRICAL WORK WITH ARCHITECTURAL DRAWINGS PRIOR TO ROUGH-IN OF WIRING.
- ALL WIRING SHALL BE CONCEALED IN WALLS AND ABOVE CEILING SPACES WHEREVER POSSIBLE UNLESS EXTRAORDINARY CONDITIONS EXISTS THAT DO NOT PERMIT THE WIRING TO BE CONCEALED.
- CIRCUIT NUMBERS ON THE PLANS ARE FOR REFERENCE ONLY. CONTRACTOR WILL DETERMINE EXACT CIRCUITING ARRANGEMENT IN FIELD.
- SIZE AND LOCATION OF JUNCTION BOXES SHALL BE AS PER ACCORDANCE WITH THE 2020 N.E.C. AND ALL OTHER APPLICABLE LOCAL CODES.
- CONDUIT ELEVATIONS ARE TO BE FIELD DETERMINED AT TIME OF INSTALLATION.
- CONTRACTOR TO FIELD VERIFY ALL ELECTRICAL CONNECTION POINTS ON NEW EQUIPMENT BEFORE ROUTING NEW ELECTRICAL SERVICES.
- THE CONTRACTOR IS TO PROVIDE A PERMANENT NAMEPLATE AT EACH PIECE OF NEW EQUIPMENT INSTALLED DENOTING THE UNIT TAG. NO., PANELBOARD DESIGNATION AND CIRCUIT NO. NEW NAMEPLATES TO BE APPROVED BY OWNER BEFORE APPLICATION.
- THE CONTRACTOR IS TO COORDINATE THE WORK WITH OTHER TRADES.
- ELECTRICAL EQUIPMENT & CONDUIT IS SHOWN DIAGRAMMATICALLY FOR DRAWING CLARITY. BEST LOCATIONS AND ROUTING TO BE FIELD DETERMINED BY THE CONTRACTOR AT TIME OF INSTALLATION.
- UPON COMPLETION OF WORK THE CONTRACTOR SHALL UPDATE ALL AFFECTED PANEL SCHEDULES TO CLEARLY IDENTIFY EACH CIRCUIT USED FOR THIS PROJECT.
- DISCONNECT SWITCHES SHALL BE PROVIDED, INSTALLED AND WIRED BY CONTRACTOR UON.
- ALL WALL/FLOOR PENETRATIONS ARE TO BE BACK FILLED WITH AN NFPA APPROVED FIRE STOPPING COMPOUND SUITABLE TO THE AREA.
- ALL ELECTRICAL WORK ABOVE CEILING TO BE PLENUM RATED.
- CONTRACTOR SHALL INSPECT BOTH SIDES OF ANY WALL, FLOOR, OR ROOF PENETRATIONS FOR OBSTRUCTIONS PRIOR TO STARTING THE WORK. ALL ROOF PENETRATIONS MUST BE COORDINATED WITH OWNER ROOF VENDOR TO MAINTAIN ROOF WARRANTY. ALL WALL AND FLOOR PENETRATIONS MUST BE SEALED WITH FIRE RATING EQUAL TO OR EXCEEDING THE EXISTING FIRE RATING.

**KEY NOTES:**


- CONTRACTOR SHALL PROVIDE AND INSTALL A MOTOR RATED TOGGLE SWITCH WITH LOCKING MECHANISM AT EACH UNIT VENTILATOR AND ROUTE WIRING AS INDICATED ON DWG. SO UNITS ARE CONNECTED IN PARALLEL. PROVIDE PANEL AND CIRCUIT INFORM. AT EACH MOTOR RATED SWITCH. PROVIDE AND INSTALL A 1P. 20A. CIRCUIT BREAKER, AND UPDATE PANEL SCHEDULE. ELECTRICAL CONTRACTOR SHALL RECONNECT POWER TO NEEDLE POINT IONIZATION. MECHANICAL CONTRACTOR SHALL REINSTALL.
- CONTRACTOR SHALL RE-CONNECT NEW CEILING MOUNTED RECEPTACLE TO EXISTING CIRCUIT.
- CONTRACTOR SHALL RELOCATE ANY/ALL ELECTRICAL COMMODITIES TO BE IMPACTED WITHIN SCOPE OF WORK.
- FINAL ELECTRICAL CONNECTION BY CONTRACTOR. SEE DRAWING E15.

**FIRE ALARM KEY NOTE:**

- NEW CEILING MOUNTED CARBON MONOXIDE DETECTOR WIRED AND INSTALLED BY ELECTRICAL CONTRACTOR. DETECTOR TO BE MOUNTED AT THE FIRST SUPPLY AIR DIFFUSER. CONFIRM LOCATION WITH MECHANICAL DRAWINGS. CONTRACTOR TO PROVIDE A "TROUBLE" ALARM CIRCUIT AT FIRE ALARM PANEL. COORDINATE WITH PRESENT FIRE ALARM COMPANY.

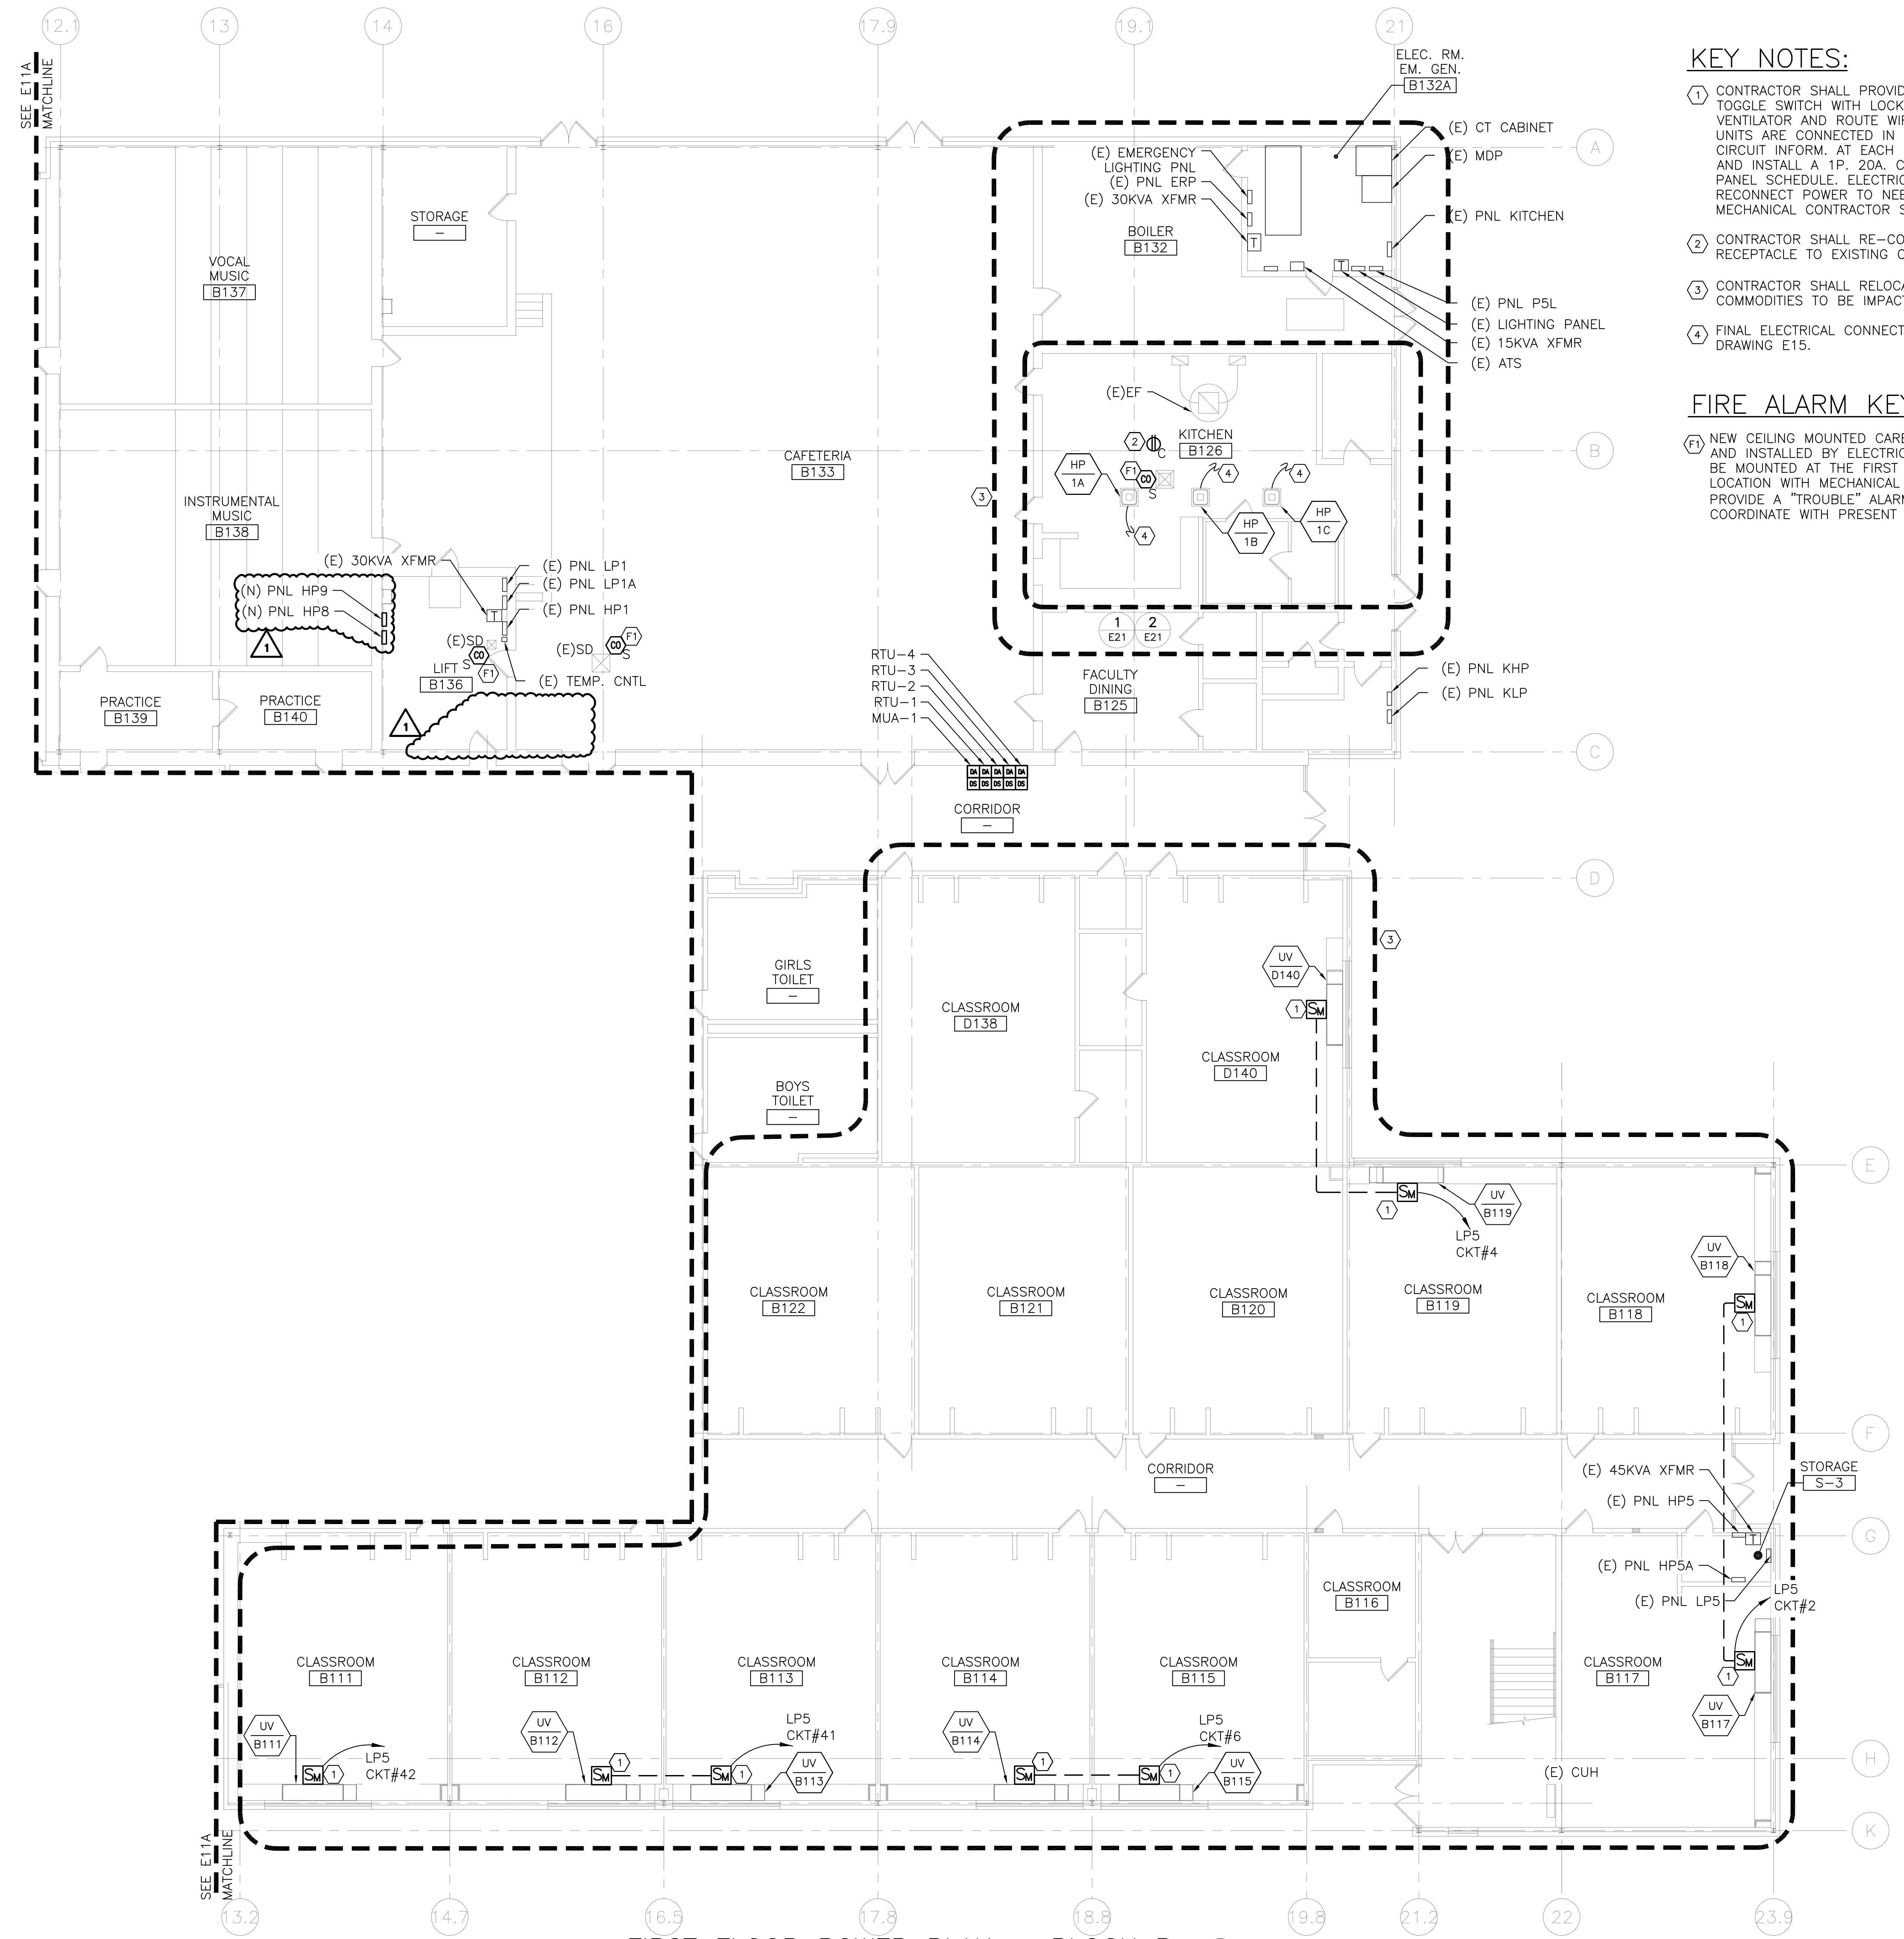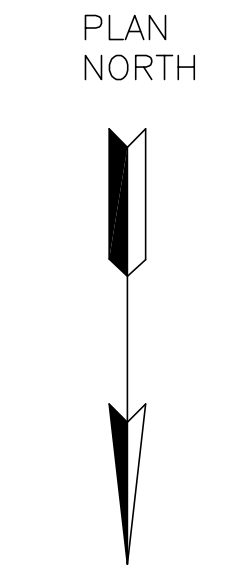

FIRST FLOOR POWER PLAN - BLOCK B  
1/8" = 1'-0" (E11B)

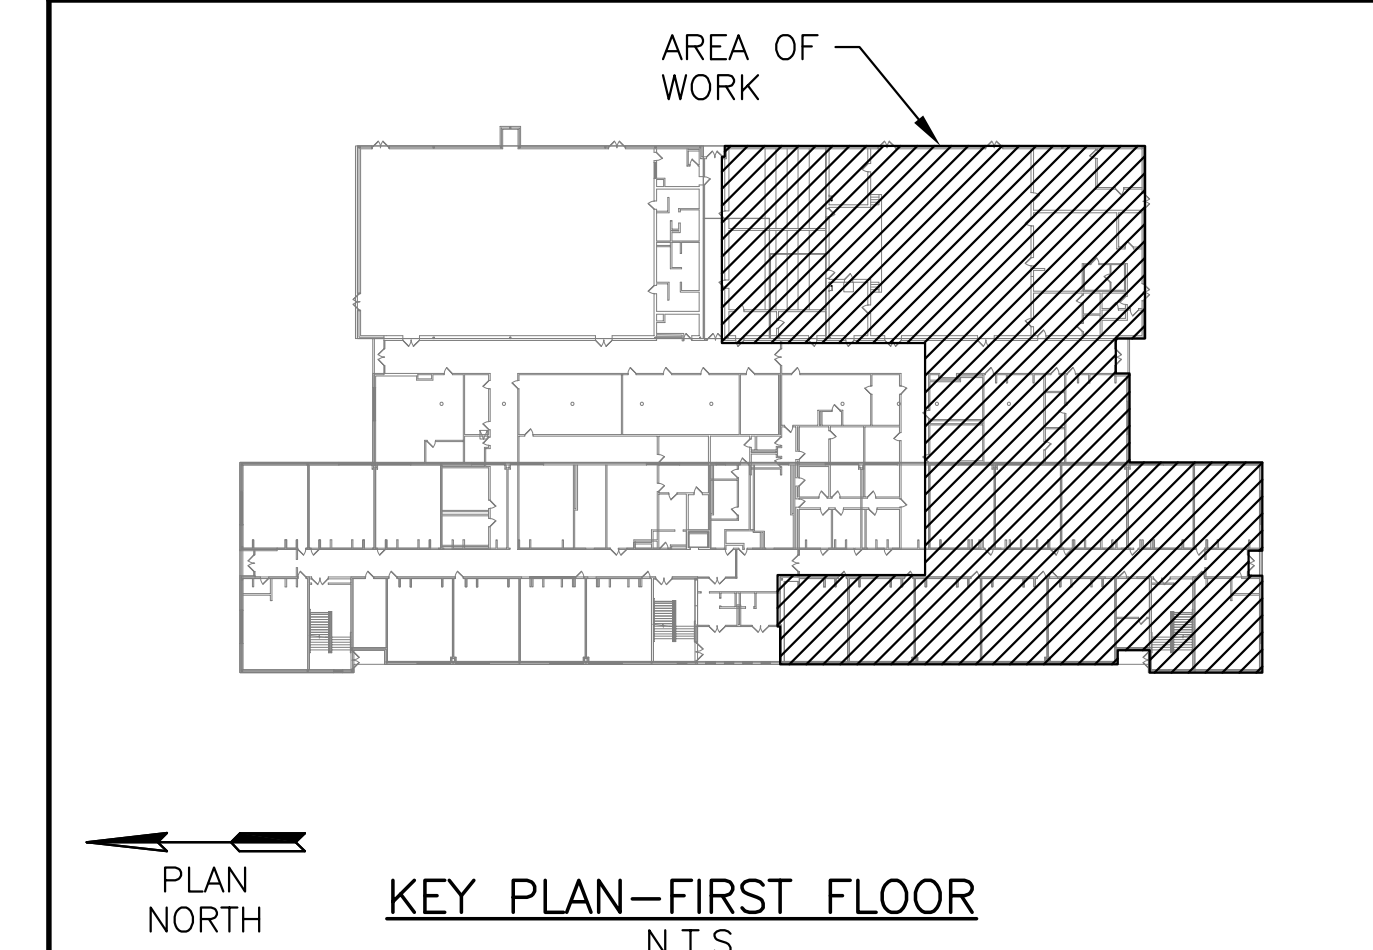

KEY PLAN - FIRST FLOOR  
N.T.S.


NJDOE STATE PROJECT NO.: T.B.D.

REV	REVISION DESCRIPTION	BY	DATE
1	ISSUED FOR ADDENDUM 1	LR	24 MAR 25
0	ISSUED FOR BID AND CONSTRUCTION	LR	14 FEB 25


**EI Associates**  
ARCHITECTS & ENGINEERS, PA  
8 RIDGEDALE AVENUE • CEDAR KNOLLS NJ 07927 • 973.775.7777

BRIAN C. HARTZEL, P.E. PROFESSIONAL ENGINEER LICENSE NO. NJ GE58995 ELECTRICAL


SCALE AS NOTED	PROJECT	EIA DRAWING NO.
DRAWN BY: [Signature]	WINSLOW TOWNSHIP SCHOOL DISTRICT	<b>E11B</b>
DESIGNED BY: [Signature]	HVAC SYSTEM UPGRADES AT SCHOOL #5	
CHECKED BY: [Signature]	WINSLOW NEW JERSEY	CLIENT DWG. NO. -----
APPROVED BY: [Signature]	TITLE	EIA PROJECT NO. ES9782.01
PROJECT MANAGER:	PARTIAL FIRST FLOOR POWER PLAN	

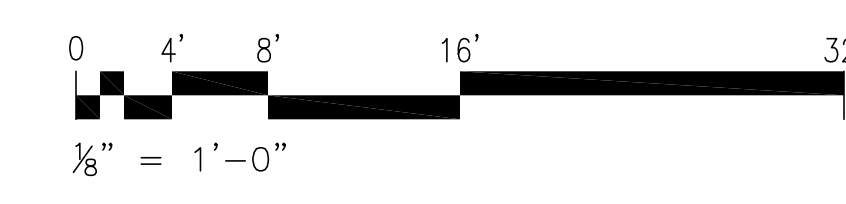



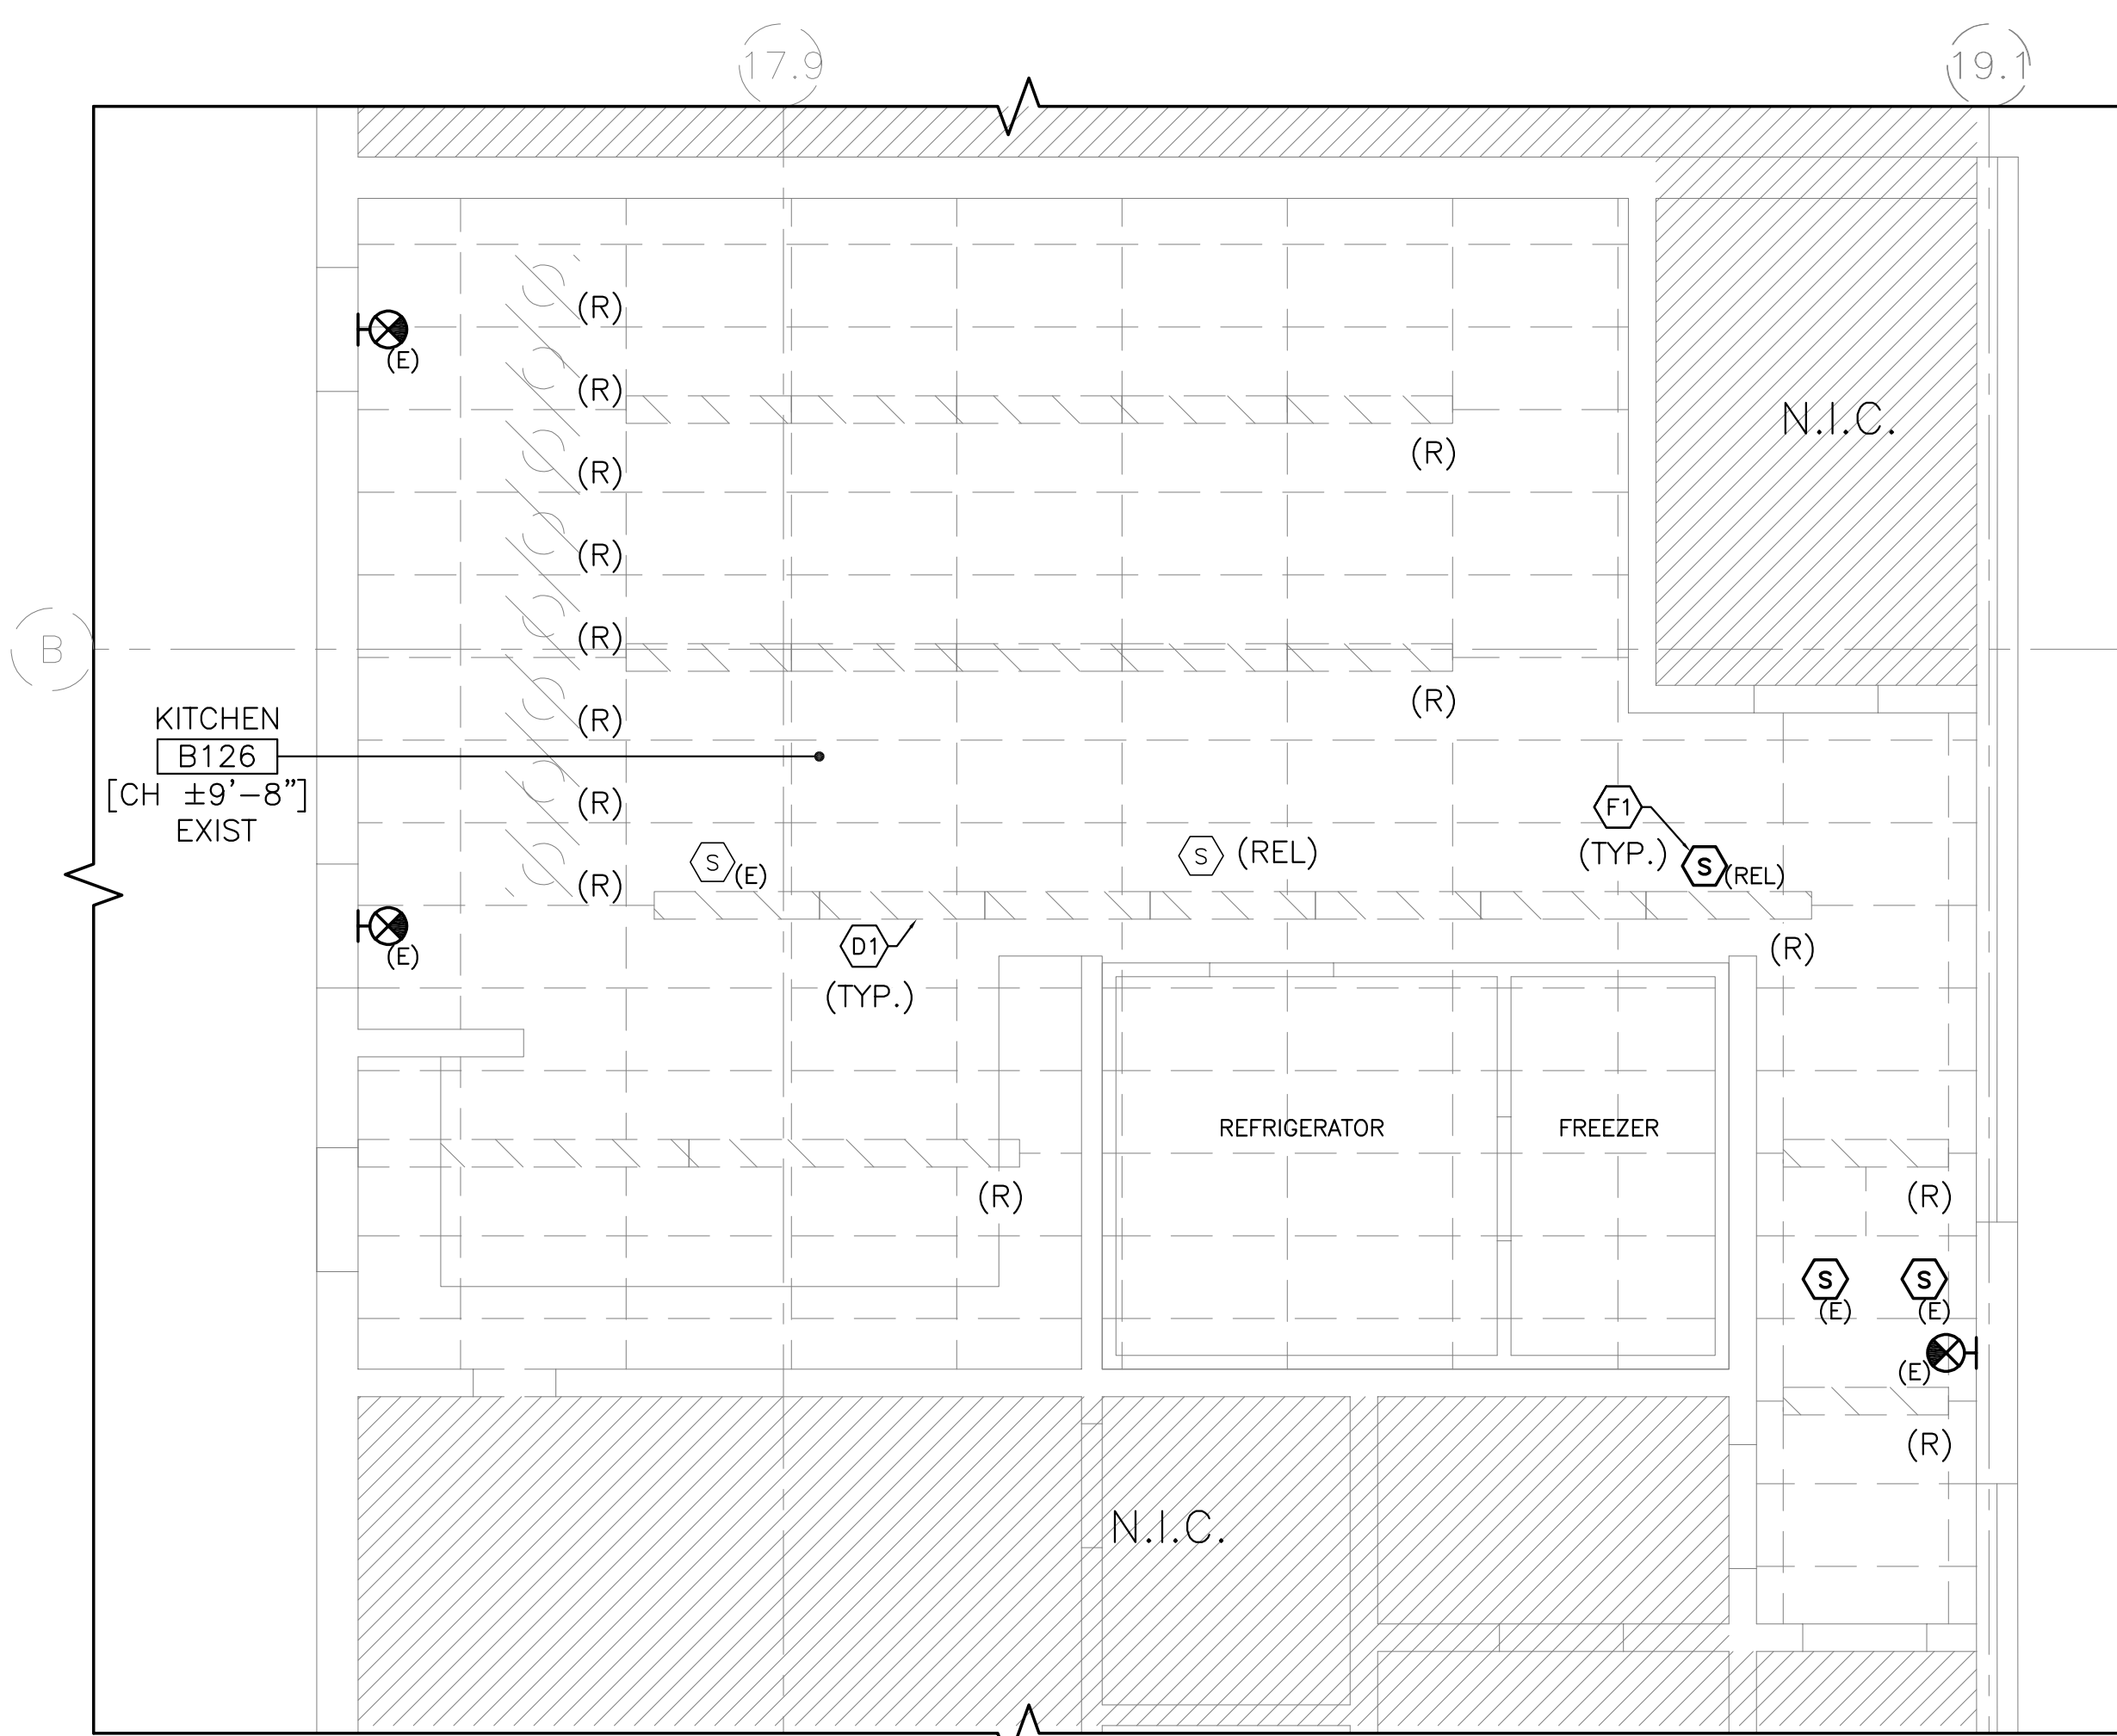


PARTIAL FIRST FLOOR @ KITCHEN  
DEMOLITION LIGHTING PLAN 1  
1/4" = 1'-0" E21

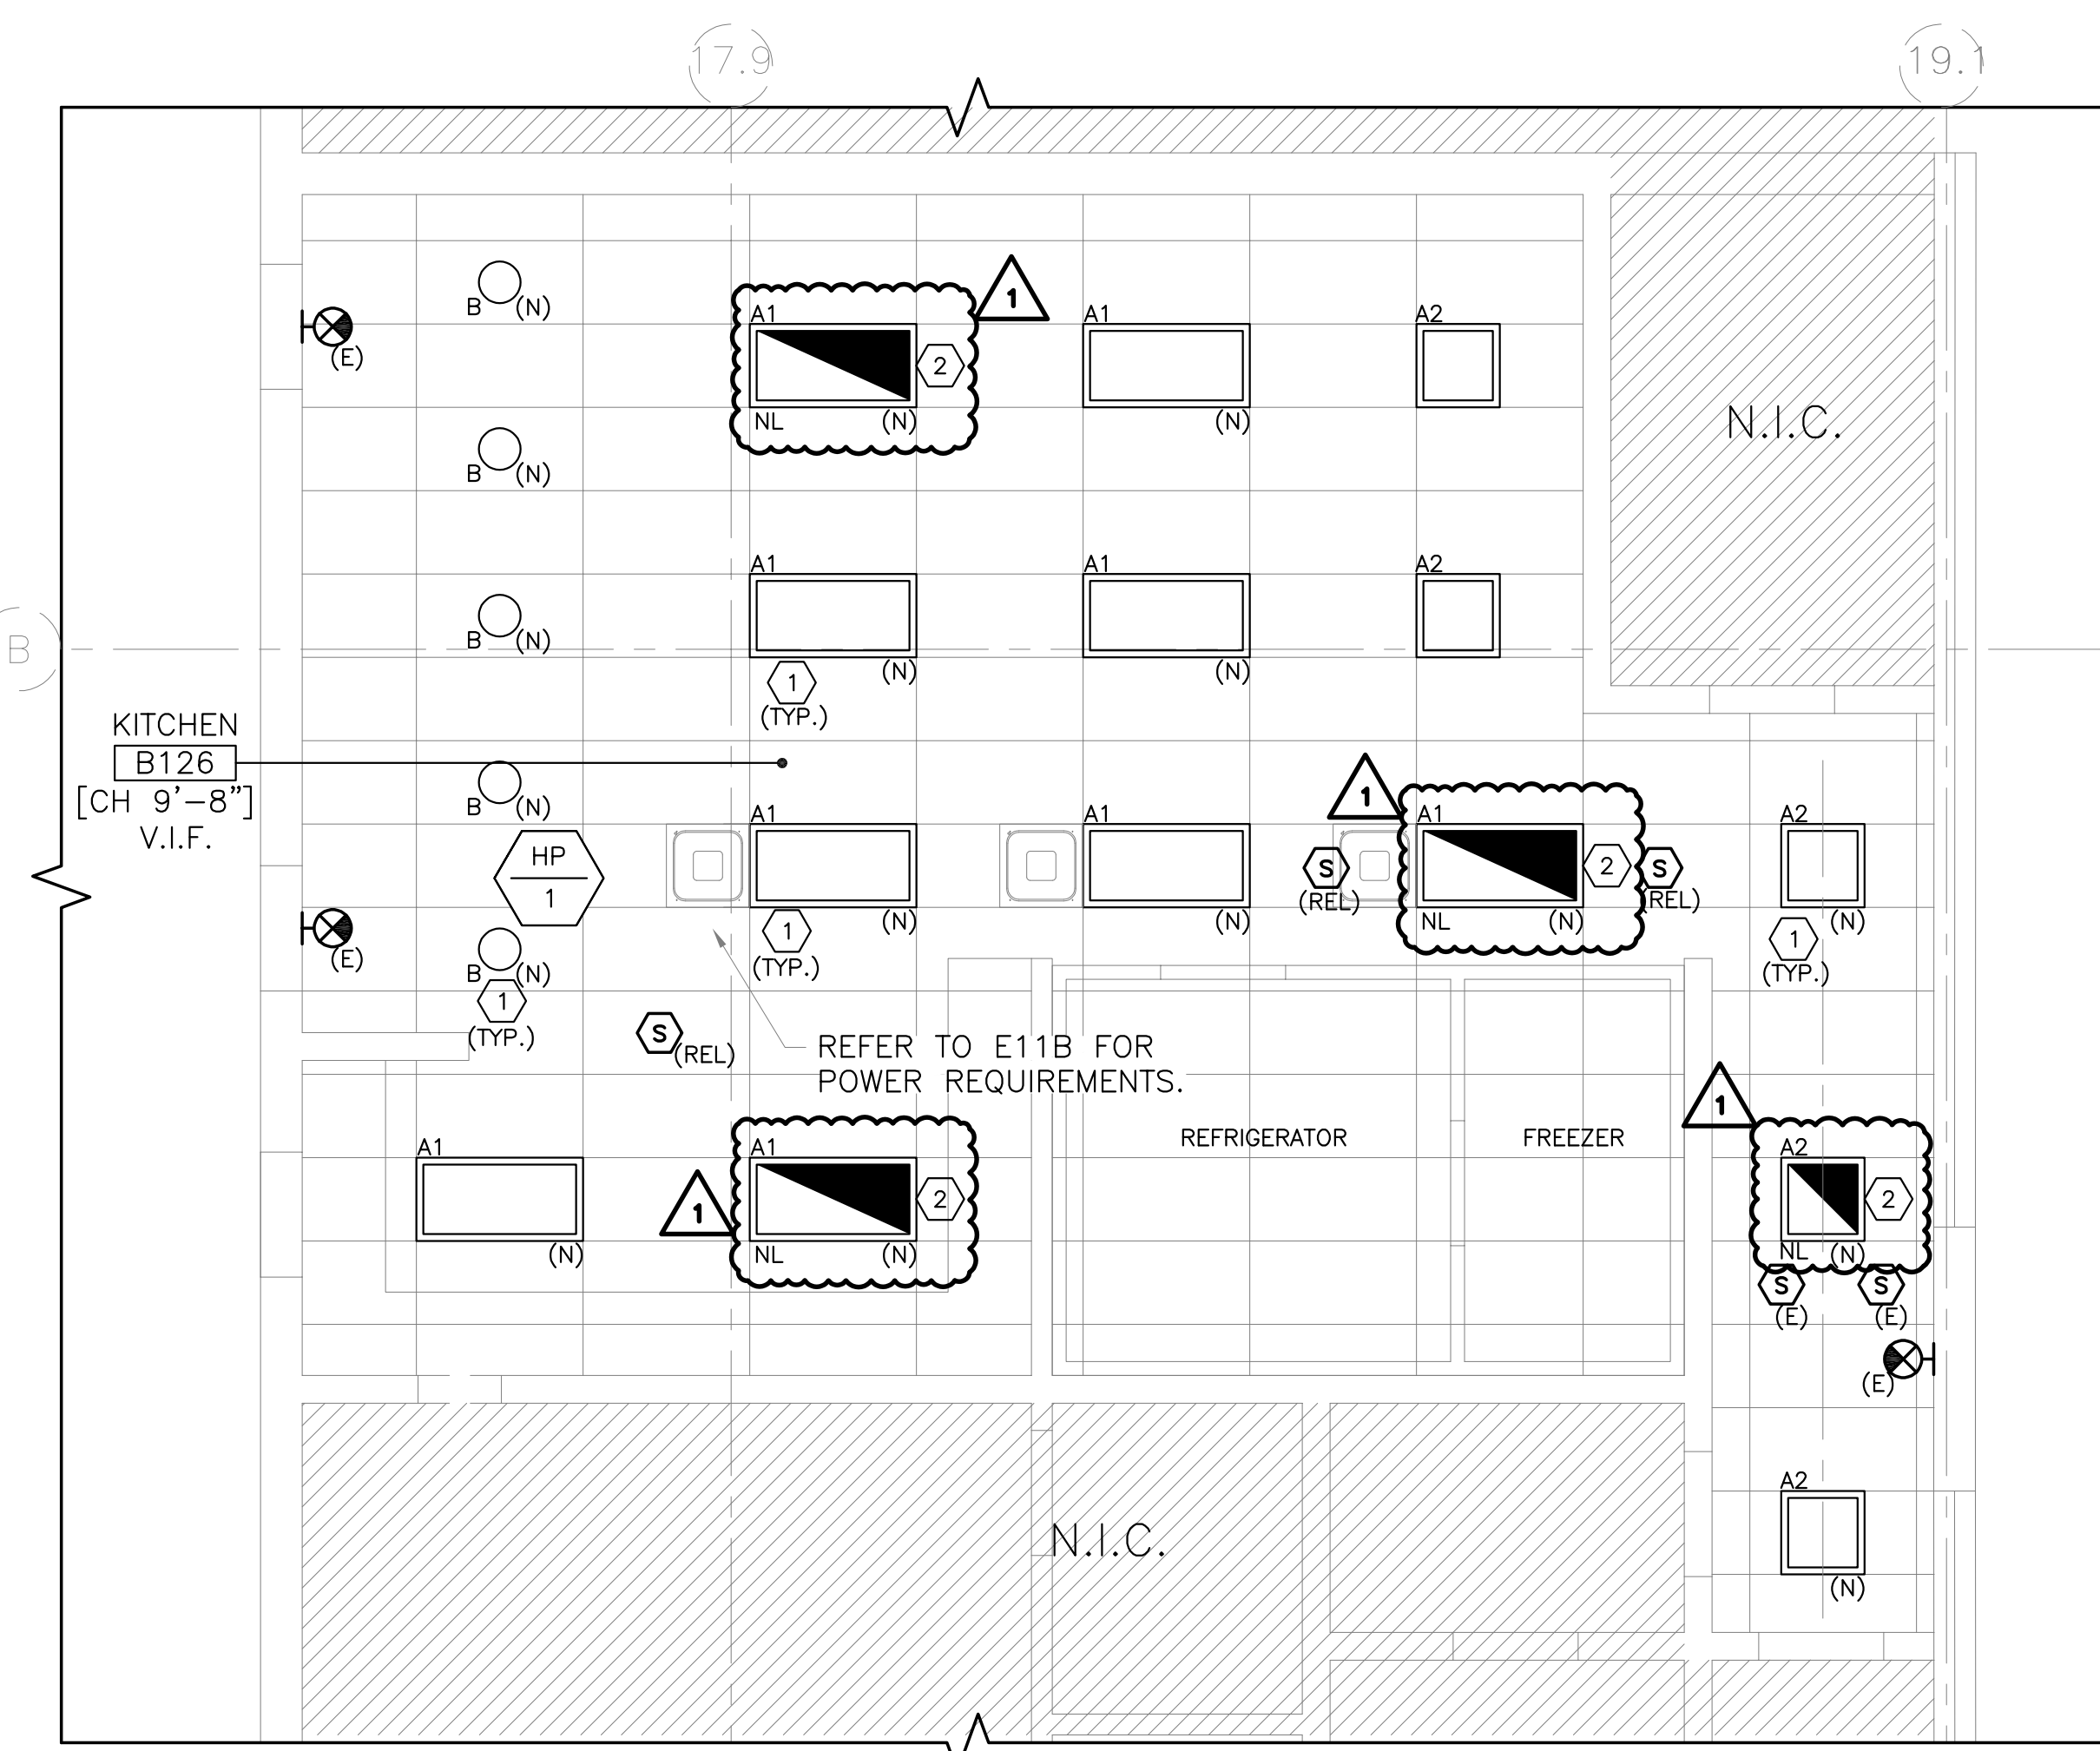

PARTIAL FIRST FLOOR @ KITCHEN  
LIGHTING PLAN 2  
1/4" = 1'-0" E21

GENERAL NOTES:

- REFER TO DRAWING NUMBER E00 FOR GENERAL NOTES, ABBREVIATIONS, SYMBOLS AND DEMOLITION NOTES.
- REFER TO DRAWING E50 FOR PANEL SCHEDULES AND CIRCUIT INFORMATION.
- THE CONTRACTOR SHALL FIELD VERIFY EXISTING BRANCH CIRCUITS AND FEEDERS PRIOR TO START OF DEMOLITION. BRANCH CIRCUITS AND FEEDERS AFFECTED BY RENOVATION AND DEMOLITION WORK SHALL BE RE-ROUTED, EXTENDED AND/OR REWIRED AS REQUIRED FOR NEW CONSTRUCTION.
- THE CONTRACTOR SHALL WIRE AND RELOCATE EXISTING ELECTRICAL EQUIPMENT INDICATED ON THE PLANS. REFER TO DEMOLITION NOTES FOR OTHER ELECTRICAL SYSTEMS EXTENT OF WORK IN DEMOLITION AND RENOVATED AREAS. COMPLY WITH CODES AND STANDARDS.
- UTILIZE AND RELOCATE AS INDICATED ON DRAWINGS FIRE ALARM DEVICES, SPEAKERS, CLOCKS, INTRUSION DETECTION DEVICES, WIRING DEVICES ETC. AFFECTED BY RENOVATION WORK.
- CIRCUIT BREAKERS BEING MADE SPARE BY REMOVALS IN DEMOLISHED AND RENOVATED AREAS MAY BE RE-USED FOR NEW WORK WHEN NO OTHER CIRCUITS IN THE PANEL ARE AVAILABLE. THE CONTRACTOR SHALL DETERMINE ACCURATE EXISTING CIRCUITING ARRANGEMENTS IN THE FIELD AND UPDATE PANEL DIRECTORIES (TYPE WRITTEN) THAT ARE BEING AFFECTED BY THIS WORK. EXISTING 15A AND 20A CIRCUITS UTILIZED SHALL NOT EXCEED TOTAL CONNECTED LOAD OF 10 AMPS AND 14 AMPS AT 120V PER CIRCUIT, RESPECTIVELY.
- REFER TO MECHANICAL DEMOLITION PLANS FOR MECHANICAL EQUIPMENT TO BE REMOVED. THE CONTRACTOR SHALL REMOVE POWER WIRING, CONDUIT, AND CONNECTIONS FROM EQUIPMENT SHOWN TO BE REMOVED ON MECHANICAL PLANS AND SCHEDULE OUTAGE OF MECHANICAL EQUIPMENT.
- ALL EXISTING ELECTRICAL EQUIPMENT SHOWN OR NOT, THAT IS NOT AFFECTED BY DEMOLITION AND RENOVATION SHALL REMAIN, AND BE COVERED AND PROTECTED DURING CONSTRUCTION. USE UL APPROVED AND LISTED COVERS FOR FIRE ALARM DEVICES.
- WHETHER SHOWN OR NOT ON THE DEMOLITION PLANS, THE CONTRACTOR IS REQUIRED TO REMOVE, RELOCATE, RECONNECT, AND/OR REWIRE ALL ELECTRICAL, AUXILIARY SYSTEMS AND ASSOCIATED EQUIPMENT AFFECTED BY DEMOLITION, INCLUDING ABANDONED CABLES.
- ELECTRICAL EQUIPMENT AND WIRING TO BE REMOVED IN RENOVATED AND AFFECTED AREAS IS NOT ALL SHOWN ON THIS DRAWING. IT IS THE CONTRACTOR'S RESPONSIBILITY TO IDENTIFY, CONFIRM AND COORDINATE WITH THE OWNER. THERE WILL BE NO EXTRA COST BY THE OWNER FOR ANY MISSED EQUIPMENT AND WIRING TO BE REMOVED.
- THE CONTRACTOR IS TO FIELD VERIFY, DISCONNECT AND MAKE SAFE ALL POWER SOURCES BEFORE BEGINNING DEMOLITION.

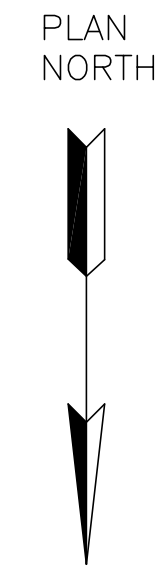

FIRE ALARM KEY NOTE:

- (F1) CONTRACTOR SHALL REMOVE, STORE AND REINSTALL ALL FIRE ALARM SYSTEM DEVICES AFTER INSTALLATION OF NEW DEVICES.

DEMOLITION KEY NOTE:

- (D1) CONTRACTOR SHALL FIELD VERIFY, CONFIRM THE EXISTING CIRCUITS FEEDING THE EXISTING LIGHTING, DISCONNECT AND MAKE SAFE PRIOR TO DEMOLITION. DEMOLISH ALL EXISTING LIGHTING FIXTURES, CONDUIT AND WIRE IN THE KITCHEN BACK TO SOURCE PANEL. RE-USE EXISTING CIRCUITS UNDER NEW WORK.


NEW WORK KEY NOTES:

- (1) CONTRACTOR SHALL PROVIDE AND INSTALL NEW CONDUIT AND WIRE FOR NEW LIGHT FIXTURES. CIRCUIT LIGHTS TO PANEL KLP. REFER TO E50 FOR ADDITIONAL INFORMATION.
- (2) THE FOLLOWING FIXTURES SHALL BE CONNECTED TO GENERATOR BACKED PANEL KHP CIRCUIT #3.

SYMBOL LIST

- INDOOR LIGHTING FIXTURE ON GENERATOR BACKED PANEL.
- INDOOR LIGHTING FIXTURE ON GENERATOR BACKED PANEL.

TYPE	SYMBOL	DESCRIPTION	LAMPS		DRIVER TYPE	LUMINAIRE			MOUNTING	MOUNTING HEIGHT	MANUFACTURER CATALOG SERIES
			CCT	TYPE		VA	VOLTAGE	LUMENS			
A1		FRAME 2X4 FLAT PANEL	4000K	LED	-	30.2W	MVOLT	4260L	RECESSED	RECESSED	LITHONIA CAT. LFRM-2X4-AL08-SWW7-MVOLT-M6-IE10WCP.
A2		FRAME 2X2 FLAT PANEL	4000K	LED	-	23W	MVOLT	3230L	RECESSED	RECESSED	LITHONIA CAT. LFRM-2X2-AL03-SWW7-MVOLT-M6-IE10WCP.
B		WAFER LED DOWNLIGHT	3500K	LED	-	13W	120V	76L/W	RECESSED	RECESSED	JUNO CAT. WF6-SWW5-90CRI

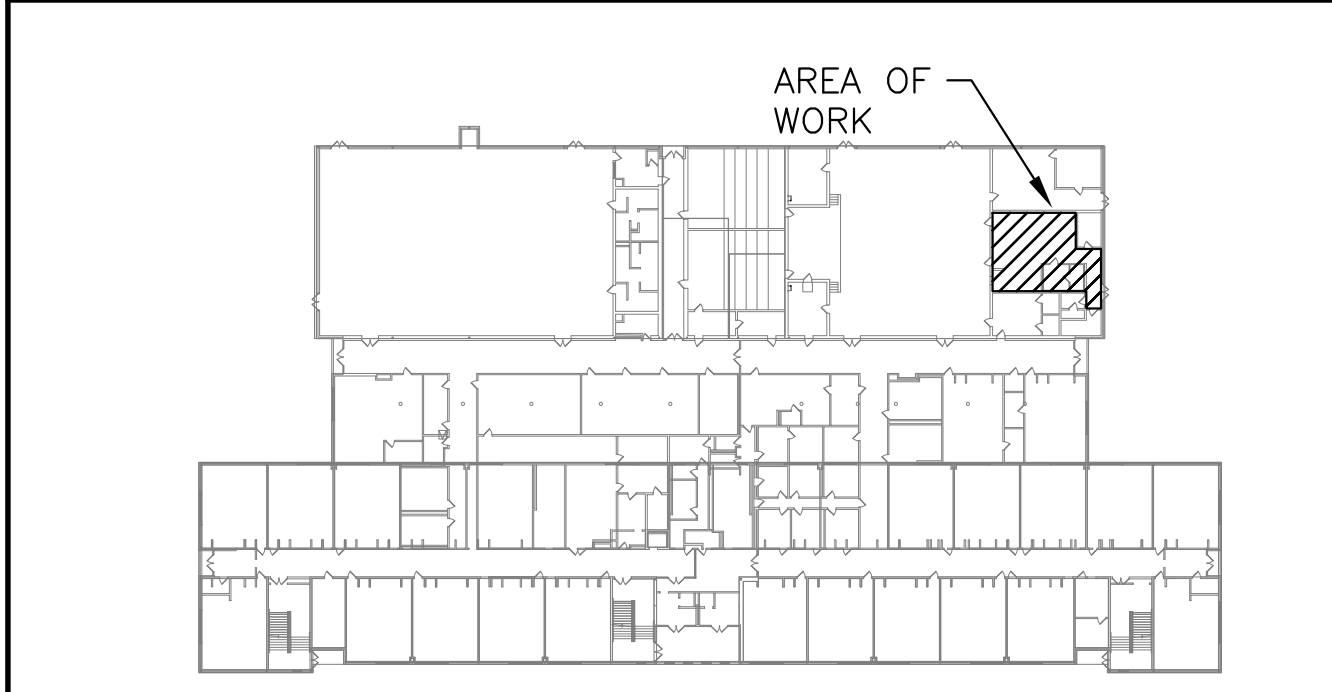

KEY PLAN-FIRST FLOOR  
N.T.S.

NJDOE STATE PROJECT NO.: T.B.D.



REV	REVISION DESCRIPTION	BY	DATE
1	ISSUED FOR ADDENDUM 1	LR	24 MAR 25
0	ISSUED FOR BID AND CONSTRUCTION	LR	14 FEB 25

**EI Associates**  
ARCHITECTS & ENGINEERS, PA  
8 RIDGEDALE AVENUE CEDAR KNOLLS NJ 07927-973.775.7777


BRIAN C. HARTZEL, P.E. PROFESSIONAL ENGINEER LICENSE NO. NJ GE58995 ELECTRICAL

SCALE AS NOTED PROJECT  
DRAWN BY: WINSLow TOWNSHIP SCHOOL DISTRICT  
DESIGNED BY: HVAC SYSTEM UPGRADES AT SCHOOL #5  
CHECKED BY: WINSLow NEW JERSEY  
APPROVED BY: TITLE  
PROJECT MANAGER: KITCHEN DEMOLITION & NEW LIGHTING PLAN

EIA DRAWING NO. **E21**  
CLIENT DWG. NO. \_\_\_\_\_  
EIA PROJECT NO. ES9782.01

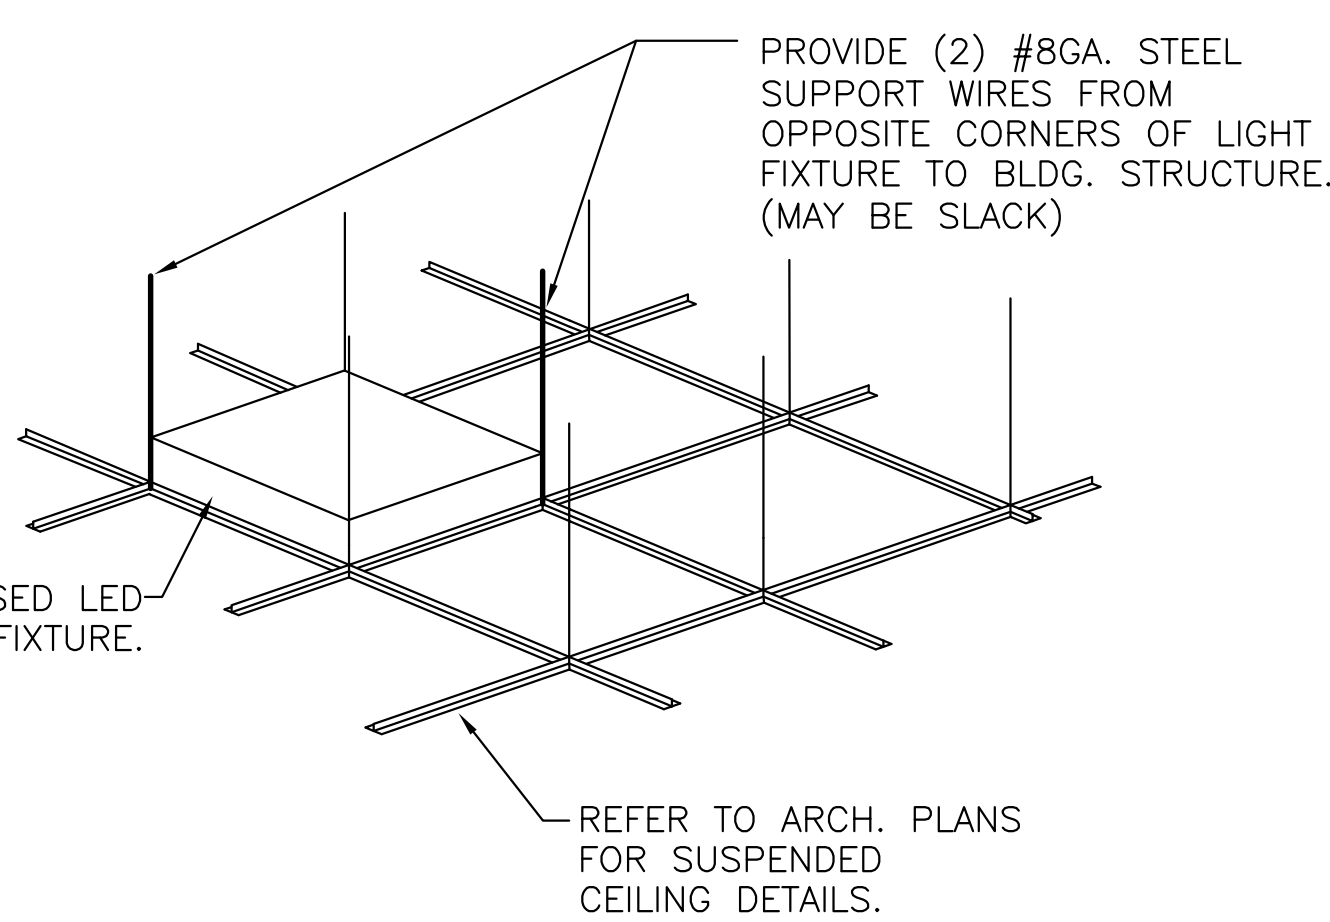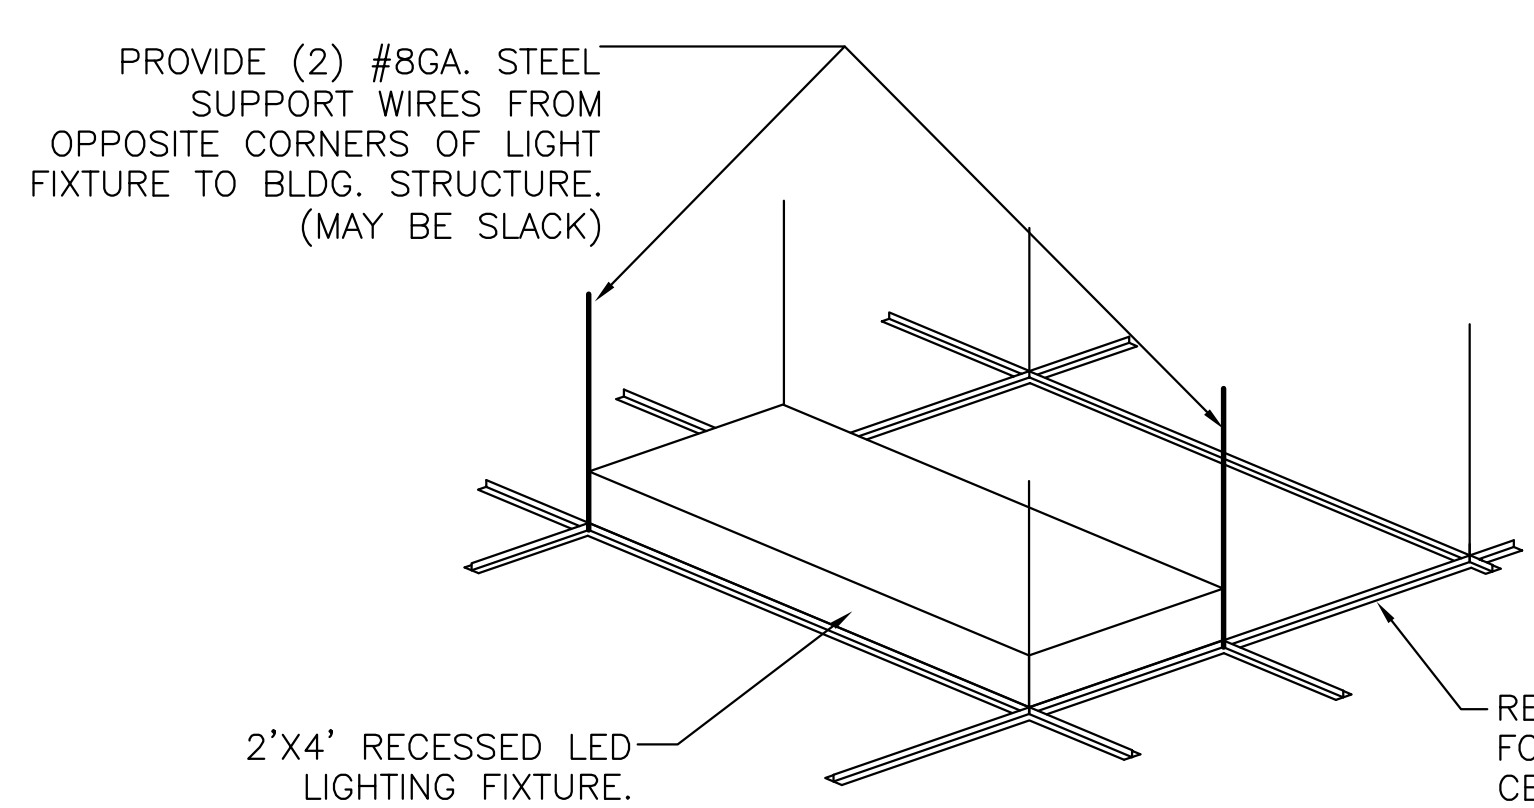

RECESSED LIGHTING FIXTURE SUPPORT DETAILS  
N.T.S. 3 E21

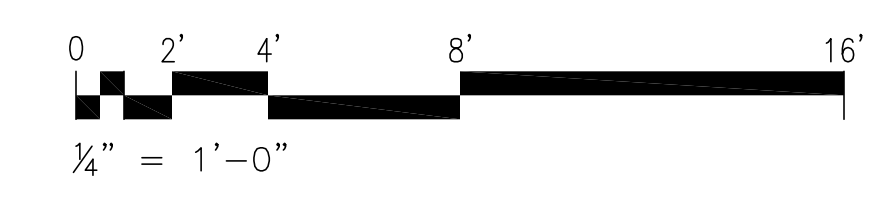


**GENERAL NOTES:**

- REFER TO DRAWING E00 FOR GENERAL NOTES, ABBREVIATIONS SYMBOL LIST AND NOTES.

**KEY NOTES:**

- 3#3, 1#8G IN 1 1/2" C
- (2) SETS 4#3/0, 1#6G IN 2" C
- 3#3, 1#8G IN 1 1/2" C

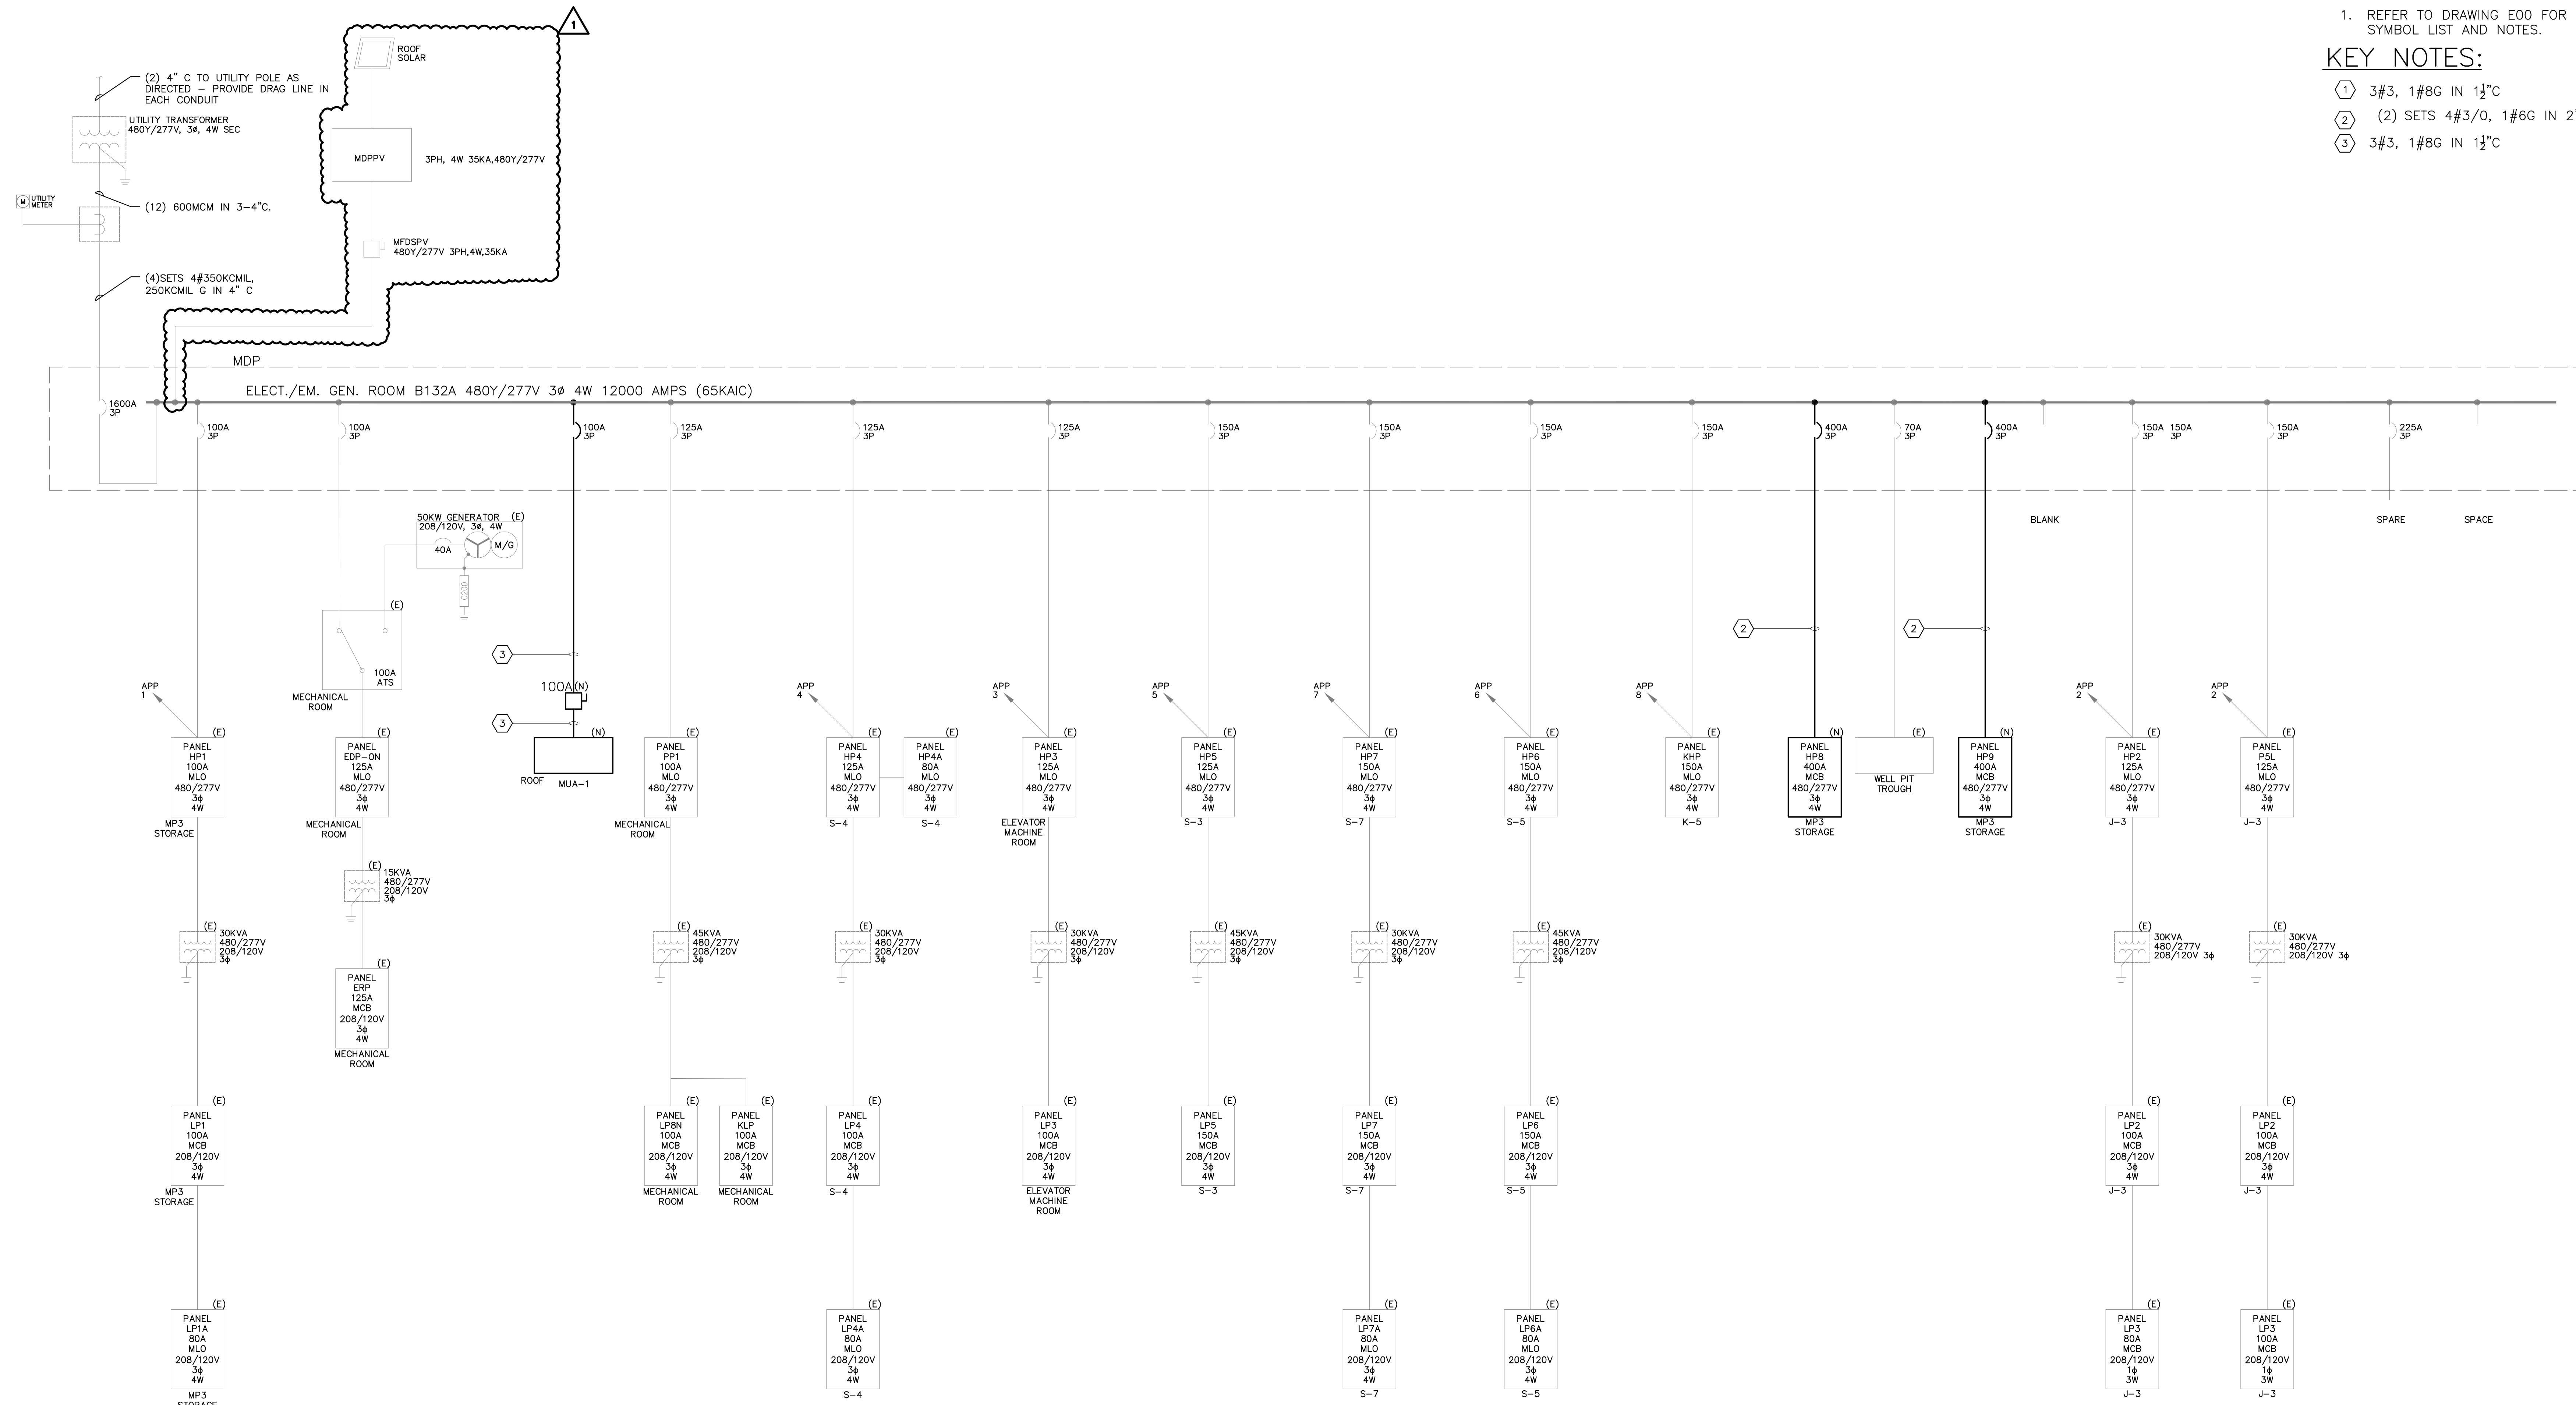


NEW ELECTRICAL ONE-LINE DIAGRAM 1  
N.T.S. E40

NJDOE STATE PROJECT NO.: T.B.D.			
REV	REVISION DESCRIPTION	BY	DATE
1	ISSUED FOR ADDENDUM 1	LR	24 MAR 25
0	ISSUED FOR BID AND CONSTRUCTION	LR	14 FEB 25
<b>EI Associates</b> ARCHITECTURE ENGINEERING PLANNING ARCHITECTS & ENGINEERS, PA 8 RIDGEDALE AVENUE CEDAR KNOLLS NJ 07927*973.775.7777			
BRIAN C. HARTZEL, P.E.		PROFESSIONAL ENGINEER LICENSE NO. NJ GE58995	ELECTRICAL
SCALE	AS NOTED	PROJECT	EIA DRAWING NO.
DRAWN BY:	DESIGNED BY:	CHECKED BY:	APPROVED BY:
WINSLOW TOWNSHIP SCHOOL DISTRICT HVAC SYSTEM UPGRADES AT SCHOOL #5 WINSLOW NEW JERSEY			<b>E40</b>
TITLE			CLIENT DWG. NO.
NEW ELECTRICAL ONE-LINE DIAGRAM			EIA PROJECT NO. ES9782.01

**GENERAL NOTES:**

- REFER TO DRAWING E00 FOR GENERAL NOTES, ABBREVIATIONS SYMBOL LIST AND NOTES.

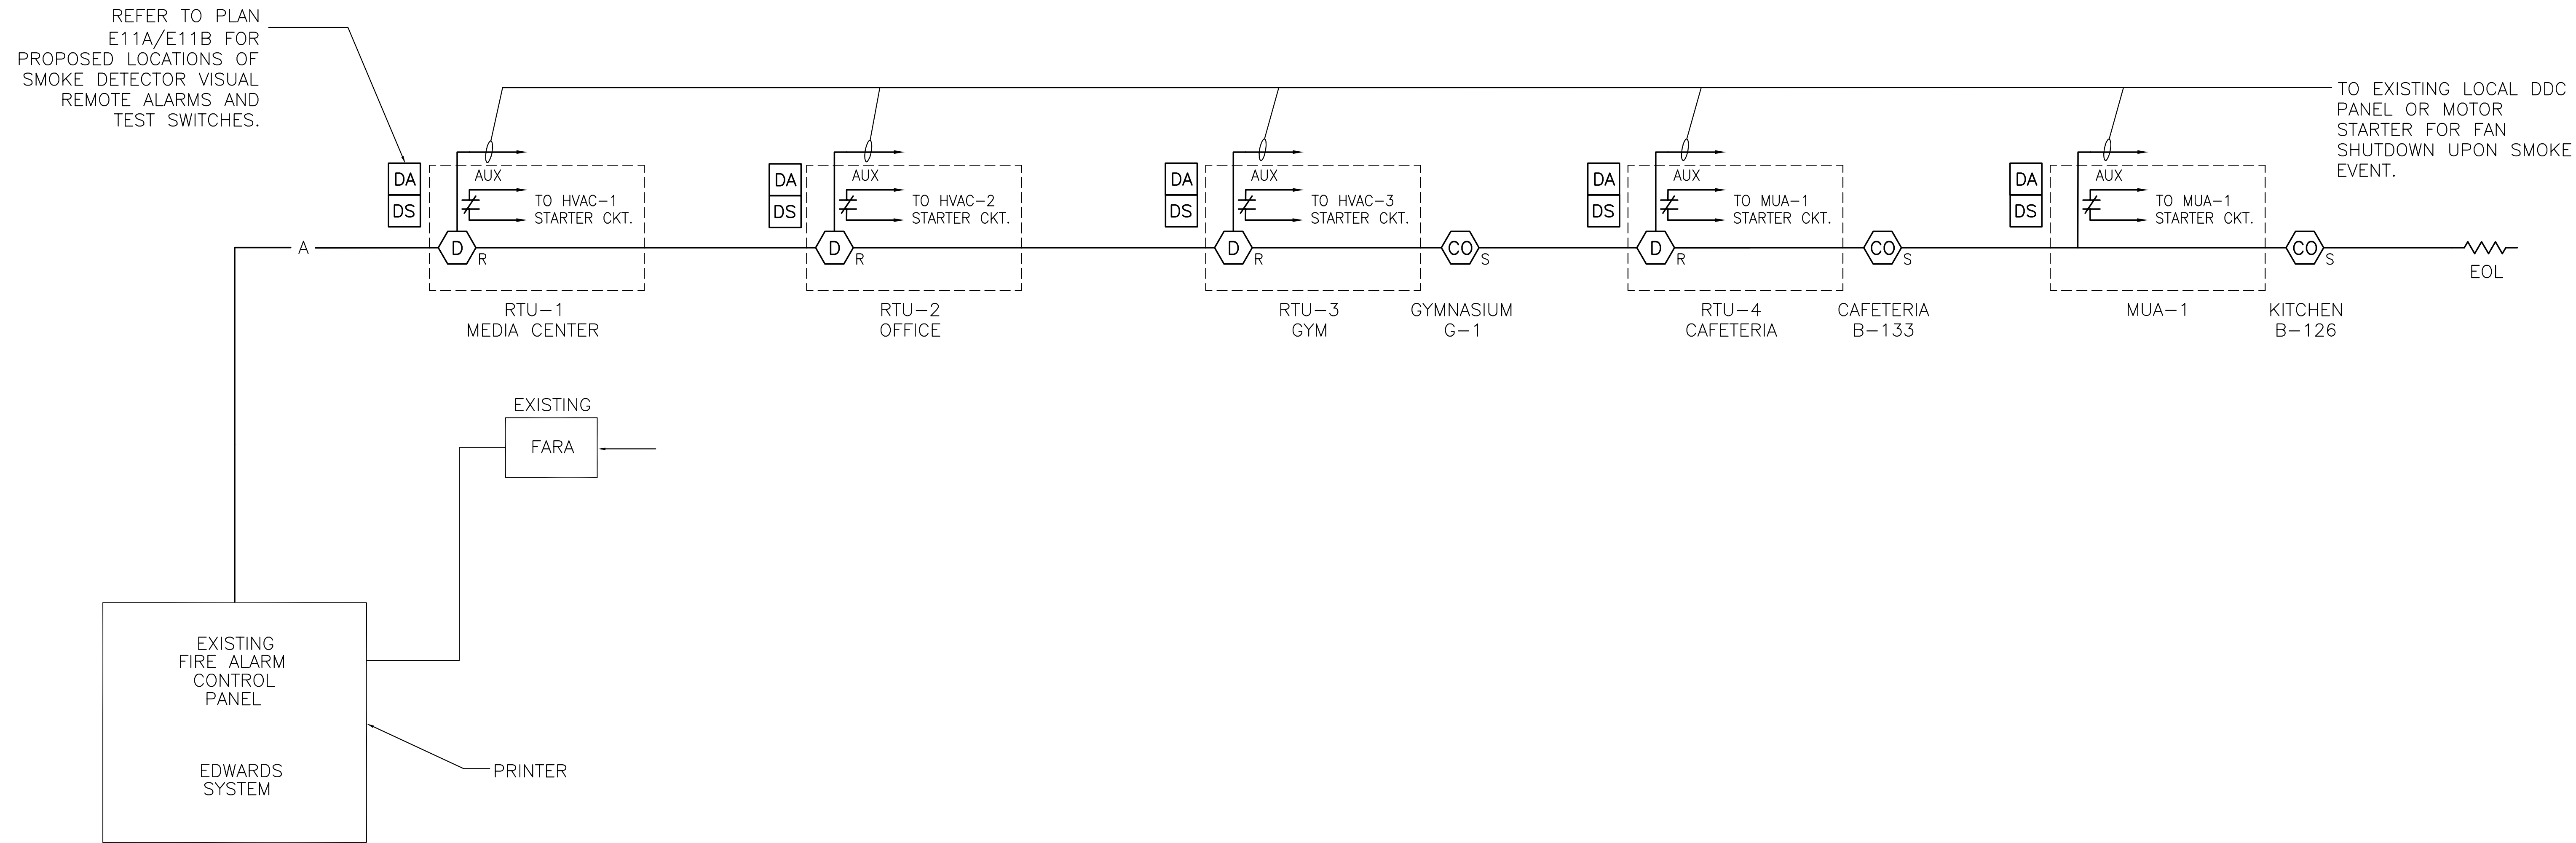

VENDOR:  
FRANKLIN ALARM  
COMPANY INC.  
P.O. BOX 84 FRANKVILLE,  
NJ 08322  
LIC. NO. P00348  
(856)-728-6424

**PARTIAL FIRE ALARM RISER**

1  
E60

CONTRACTOR IS RESPONSIBLE FOR ALL FIRE ALARM SYSTEM UPDATES, I.E. (PROGRAMMING, CONFIRM BATTERY SIZE, QUANTITY OF ZONES, POWER SUPPLY, ETC.)

NJDOE STATE PROJECT NO.: T.B.D.			
0	ISSUED FOR ADDENDUM 1	LR	24 MAR 25
0	ISSUED FOR BID AND CONSTRUCTION	LR	14 FEB 25
REV	REVISION DESCRIPTION	BY	DATE
<b>EI Associates</b> ARCHITECTURE ARCHITECTS & ENGINEERS, PA ENGINEERING PLANNING 8 RIDGEDALE AVENUE CEDAR KNOLLS NJ 07927-973.7777			
BRIAN C. HARTZEL, P.E.		PROFESSIONAL ENGINEER LICENSE NO. NJ GE58995	ELECTRICAL
SCALE	AS NOTED	PROJECT	EIA DRAWING NO.
DRAWN BY:			
DESIGNED BY:			
CHECKED BY:			
APPROVED BY:			
PROJECT MANAGER:			
WINSLOW TOWNSHIP SCHOOL DISTRICT HVAC SYSTEM UPGRADES AT SCHOOL #5 WINSLOW NEW JERSEY		<b>E60</b> CLIENT DWG. NO. ----- EIA PROJECT NO. ES9782.01	

SECTION 230900 – INSTRUMENTATION AND CONTROLS FOR HVAC

PART 1 – GENERAL

1.01 RELATED DOCUMENTS

1. Drawing and general provisions of the Contract, including General and Supplementary Conditions and Divisions 01 Specification Sections, apply to this Section.
2. Related Sections include:
  - a. Section 012300 “Alternates”.
  - b. Section 230993 “Sequence of Operations for HVAC Controls”.

1.02 SCOPE / SUMMARY

1. Provide a fully integrated Web Browser Control System incorporating Direct Digital Control (DDC) Technology with energy management, equipment monitoring, and remote communications.
2. A qualified Automatic Temperature Control (ATS) Contractor shall be hired by the awarded Contractor to perform all control work on this project including, but not limited to controls demolition, providing all new controllers, control devices, control wiring, conduits, and expansion of existing controls and building management system (BMS), also known as at this District by the current controls vendor as Facility Management Control System (FMCS).
3. The ATC Contractor shall provide all materials and labor for a fully functional, correctly operating single BMS. The ATC Contractor shall provide all front end BMS graphic floor plans updates, new and modified detail equipment/system graphics, all required control points, schedules coordinated with the District and Engineer, trending, and alarms.
4. The ATC/BMS Contractor shall include and provide the controls, equipment, meters, devices, gauges, sensors and control wiring for all equipment and sequences indicated and implied in this section, Specification Section 230993 Sequence of Operations, on plans, scheduled and on the flow and control diagrams.
5. Work shall be all inclusive, including all additional controls work not specifically shown, noted, or otherwise specifically specified. Provide all additional control panels, controllers, damper and damper actuators, control valves, control devices, wiring and all associated appurtenances as required to meet the intent and requirements of this project.
6. Provide all required new controls, controllers, materials, and labor for a fully functional and accessible control system via the new/expanded existing BMS. Commission all work, points and devices to ensure system is 100% operational prior to completion of this project.
7. The existing BMS shall be expanded, modified and or replaced as required to connect all new equipment, systems and control devices/sensors to it. All existing equipment not to be removed/replaced under the scope of work for this project shall remain on the BMS without modification. ATC Contractor shall verify that existing equipment and systems to remain are fully functional at the completion of the project and make all necessary adjustments, repairs and

corrections to ensure the existing control systems are operating correctly.

- a. Existing equipment to remain on the existing/expanded BMS:
    1. Heating hot water boiler plant including pumps, sensors and all controls to remain.
    2. Existing split DX cooling, hot water heating air handling units to remain.
  - b. Existing equipment to remain with stand-alone control, not requiring controls work:
    1. Cabinet unit heaters (CUHs) and unit heaters (UH) having stand-alone and electronic or DDC controls.
    2. Convectors, finned tube and radiators having stand-alone electronic, DDC or self-contained thermostatic controls.
8. Alternates: Coordinate with Contractor for Alternates on this project. As part of this project, there are alternates that required Add pricing. ATC/BMS Contractor shall provide awarded Contractor Add pricing for such alternates. If accepted, all work associated with the alternates shall be provided for the price awarded to the Contractor, including all associated control work, at no additional cost to owner. Alternates for this project include:

Add Alternate No. 1 Entry Vestibule Air Conditioning. Proposed air conditioning system is a VRF split system which will require connection to the project's VRF gateways and to the BMS. Provide all required controls, materials and labor and work and integrate/connect to existing/expanded BMS. Add system/unit to graphic floor plan at the BMS. Provide system detail graphic with points, data and alarms. Coordinate work with Contractor and VRF equipment manufacturer for proper integration.

9. The intent of this specification Section is to provide the following features, functionality, and interface services as follows:
- a. Open Source: The Facility Management Control System (FMCS) shall Open Source, consisting of materials and components available through Open Source product procurement suppliers. Single source exclusivity or other conditions which inhibit the Owner from obtaining both materials and support services from less than three independent procurement avenues of shall not be acceptable.
  - b. Open System platform: The FMCS shall furnish and install a complete Honeywell Niagara N4 Frameworks Building Management System and an Automatic Temperature Control System including all necessary hardware, all operating and applications software necessary to perform the control sequences as called for in Section 23 09 93 "Sequence of Operation for HVAC Equipment", BMS Diagrammatic Details, as shown on the project drawings. The new DDC controllers furnished in this section shall be an Open System platform, all programming of the shall utilize the Open Niagara N4 Platform embedded software package and communicate peer-to-peer via the Open ASHRAE 135 BACnet communications protocol.
  - c. Open Niagara Interface Conformance Statements (NICS):
    - 1). All Niagara 4 software licenses shall have the following NICS:
      - a) "accept.station.in=\*"
      - b) "accept.station.out=\*"

- c) "accept.wb.in=\*"
- d) "accept.wb.out=\*"
  - 2) All NICS shall follow the Open Niagara Interface Conformance specifications.
  - 3) All JACE hardware licenses and certificates shall be stored on local MicroSD memory card employing encrypted "safe boot" technology.
  - 4) To ensure quality, any additional JACE hardware products used on this project shall come through the Tridium Richmond, VA shipping facility.
  - 5) JACE hardware products not meeting these requirements shall not be allowed.
- d. Peer to Peer communications
  - 1) FMCS architecture shall fully support a multi-vendor environment and be able to integrate third party systems via existing vendor protocols including, as a minimum:
    - a) BACnet MS/TP
    - b) BACnet IP
    - c) LonTalk
    - d) MODBUS RTU.
- e. Web-based Graphical Interface:
  - 1) The Owner shall provide any Thin Client Web Stations (TCWS).
  - 2) The Operator shall be able manage the Building Management System through a connected Thin Client Web Station's web-browser.
  - 3) The FMCS Contractor shall provide 3-dimensional web graphics. Including all floor plans, new mechanical systems, boilers, pumps, fans, unit ventilators, roof top units, coils, etc.
  - 4) Copies of the web graphics shall be retained in the BMS Archival Data Server.
- f. Local and Remote Connectivity:
  - 1) The FMCS shall provide the owner with:
    - a) Secure local access shall be through an internal TCP/IP network connection.
    - b) Secure remote access through an Owner provided TCP/IP network connection service.
    - c) Remote connectivity with the offsite monitoring service shall be maintained by the Building Management System.
    - d) Alarm notification to designated stations and personnel through the TCP/IP network connection.
- g. Information Technology (IT) compliance and control access.
  - 1) The BMS shall be designed for use with the Owner's current enterprise level IT system.
  - 2) BMS TCP/IP devices located in IT rooms shall be fully IT compatible devices that communicate directly on the IT infrastructure in the facility.
  - 3) The ATC/BMS Contractor shall coordinate with the District to provide any and all IT drops.

10. Embedded Software:

- a) All controllers furnished by the BMS Contractor shall be programmable directly from any Niagara 4 Workbench embedded toolset.
- b) The Owner shall have full licensing and full access rights for all network management, server, engineering and programming software required for the ongoing maintenance and operation of the FMCS and shall receive all Administrator level logins and passwords.
- c) The following conditions are not acceptable:
  - 1) Systems that do not fully utilize and conform to the Open Niagara 4 Frameworks platform.
  - 2) Direct Digital Controllers that require additional software tools for post installation maintenance.
  - 3) Any additional Graphics Server or software required for Owner interface.

11. New and Existing Systems:

- a) ALL NEW FMCS DDC controllers shall as a minimum, match the existing BMS architecture capabilities **AND** shall be installed to the latest Niagara N4 capabilities as required.

12. FMCS Information Management including:

- a) System programming
- b) DDC Device downloading
- c) DDC Device backup
- d) FMCS data archiving and retrieval
- e) Data Reporting functions.
- f) Standard applications for HVAC systems.
- g) Diagnostic monitoring and reporting of BMS functions.
- h) Offsite monitoring and management access.
- i) Energy management

13. The Facility Management Control System (FMCS) shall be comprised of a network of interoperable, stand-alone digital controllers communicating on an open protocol network to the Individual Building Master Network controller. Access to the various Building Management Control Systems shall be locally from any computer or from the existing computer located in the building or remotely from any web access site and shall be accomplished through a Graphical User Interface using Web browser technology via the Internet.

**14. Contractor will provide two (2) cat-6 IP drops for integration into the Information Technology System. Coordinate with Districts' Information Technology Department.**

15. Provide Connections to all equipment requiring connections to the control medium whether furnished under this Section or not.

16. The system shall use the latest technologies available from the manufacturer in the implementation of Direct Digital Electronic Control for the HVAC system and its management.

17. The systems shall be installed by factory trained technicians, regularly employed by the manufacturer and factory trained in the installation and calibration of the product.
18. System shall be installed and serviced by technicians that are factory trained in the installation and calibration of the equipment.
19. Provide system in accordance with specifications.
20. The installing Contractor shall be a Certified Installer by the DDC Control Equipment Manufacturer. The Contractor shall include the Certification Documents from the DDC Control Equipment Manufacturer in the Shop Drawing.
21. The installing contractor will be required to provide emergency service personnel on during normal working hours.
22. The installing contractor shall be NJ DPMC pre-qualified under Classification C043 – Control Systems with an aggregate amount equal to or greater than \$15,000,000.00.
23. This Contractor shall be responsible for all software, data drops, programming, calibration, the proper operation and adjustment of all controls, dampers and appurtenances to provide required sequence of operations and protection against freeze-ups. Provide system in accordance with specifications.
24. This Contractor shall provide all labor, material, equipment and software not specifically referred to herein or on the plans, that are required to meet the functional intent of the 230900 specifications and shall be provided without any additional cost to the Owner. This Contractor shall furnish all electrical control and interlock wiring connected to the controls and instrumentation systems. All 110 VAC or greater voltage power wiring to main control panels shall be provided by this contractor, unless indicated otherwise in the Contract Documents.
25. All materials and equipment used shall be standard components, regularly manufactured for this and/or other systems and shall not be custom designed especially for this project. All components shall have been thoroughly tested and proven in actual use.
26. This Contractor shall be responsible for installation of all field equipment and the communication transmission bus. This Contractor shall supply all necessary electrical power to each controller and provide transformers as required from the electrical power panel source.
27. This Contractor shall have project's lead technician attend all commissioning meetings. This Contractor shall complete and provide to the CM and Cx all factory startup reports, and pre-functional documentation provided by the Commissioning Agent.
28. The installing contractor shall be certified in network security. Upon award, this Contractor shall provide to the Owner a Certified Compliance Statement documenting that the system has been protected against outside network intrusion. It is a requirement of this installation of this FCMS that this system is compliant with the Information Security policies and procedures of this county. Upon completion of this system, a Vulnerability Assessment shall be performed to identify current vulnerabilities and reduce the Information Security Risk for the county, architect and MEP



professionals. The awarded contractor shall provide expert advice and consultation to maintain a security posture for the organization. FCMS must be designed with a credentialed Information Security professional. Contractor personnel involved with Vulnerability Assessments and Information Security consulting must possess a current Certified Information Systems Professional (CISSP) Certification and be a member of ISCC2. An ISC2 CISSP Certification is required. These certifications shall be provided upon award of bid; no exceptions.

29. Coordinate location of thermostats, humidistats, CO2 sensors and all other exposed sensors with plans and actual field conditions.
30. The ATC Contractor shall provide all required space temperature sensors, CO2 sensors, RH sensors and associated appurtenances as required. Coordinate with unitary equipment (RTUs, etc) for any and all control sensors being provided by the equipment manufacturer. Provide all additional required sensors, wiring, controllers and labor for a fully functional system.
31. Existing unit level controllers to be reused: The existing unit ventilators being removed have relatively new controllers connected to the existing BMS. ATC Contractor shall carefully remove and then reinstall/reuse in replacement UVs if and as possible. Existing controllers to be used shall be inspected and tested to ensure that they are operating correctly prior to reuse. Replace any/all controllers which have failed or that are not functioning correctly with new.

#### 1.03 NETWORK COMMUNICATIONS

1. Building Network Controllers: Building Controllers shall be provided for HVAC equipment and networked using CAT-6 BACnet IP or MS/TP . Provide 1 Gigabit communication between BMS servers and clients. Provide 100 Megabit Peer-to-Peer communications among building controllers responsible for HVAC equipment Control.

#### 1.04 WARRANTY

1. Provide the following warranties:
  - A. Warranty on all BAS equipment and installation.
  - B. Warranty on software upgrades.
  - C. Warranty on firmware upgrades.
2. Labor and materials for the control system specified shall be warranted free from defects for a two (2) year period as indicated in "General Conditions". Control system failures during the warranty period shall be adjusted, repaired, or replaced at no additional cost or reduction in service to the Owner. This Contractor shall respond to the Owner's request for warranty service with 4 hours during normal business hours.
3. All work shall have a single warranty date. The date of "Substantial Completion" shall start the warranty. Please refer to the AIA A201 Contract Section 9.8 for the definition and requirements of substantial completion.
4. The Owner shall grant to the temperature control sub-contractor, reasonable access to the FMCS during the warranty period. The Owner shall allow the contractor to access the FMCS through a School District provided VPN from a remote location for the purpose of diagnostics and

troubleshooting, via the internet, during the warranty period.

1.05 ACCEPTABLE BAS CONTROL CONTRACTORS:

1. CM3 Building Solutions – Fort Washington, PA - (215) 322-8400  
(Basis of Design – Current/previous ATC Contractor for District)
2. A.M.E., Inc – Fairfield, NJ - (973) 884-4100
3. Honeywell Building Technologies - (856) 596-4900

1.06 POST CONSTRUCTION MAINTENANCE SERVICE (Provide separate price with Bid)

1. In addition to warranty periods per the General Conditions provide maintenance service for the warranty period of 2 years after substantial completion.
2. The base contract shall include a 2-year service/maintenance term in addition to the 2-year bonded General Contract warranty. The 2-year controls services shall include:
  - A. **Trending:** and logging remotely from the control's provider Remote from the building. A sampling of rooms as agreed by the owner include at least 20% of the rooms shall be trended to confirm proper temperature ranges are maintained.
  - B. **Alarm Monitoring:** The alarm reports shall be monitored remotely, and all alarm issues need to be addressed daily. This Contractor shall provide a weekly report that summarizes the alarm issues and the remedy actions taken.
  - C. The trending shall be summarized in a **weekly email report** to the owner. All rooms outside of the temperature and proper operating ranges shall be highlighted in the report.
  - D. The weekly email report shall be discussed in a pre-set time **conference call** that occurs every week.
  - E. Once a month, a project specific technician shall **meet onsite** with the Owner to review the weekly reports. The meeting onsite shall be a minimum of 4 hours with onsite verification, tweaking, calibrating and replacing necessary parts and operations as required to maintain the system.
  - F. Provide continued **Owner training** over the 2-year term of 24 hours.

1.07 QUALITY ASSURANCE:

1. All system components shall be fault tolerant and provide satisfactory operation without damage at 110% and 85% of rated voltage and at + 3 hertz variation in line frequency.

2. Provide static, transient, and short circuit protection on all inputs and outputs. Communication lines shall be protected against incorrect wiring, static transients and induced magnetic interface. All bus connected devices shall be a.c. coupled or approved equal so that any single device failure will not disrupt or halt bus communication.
3. The Manufacturer of the Facility Management Control System shall provide documentation supporting compliance with ISO-9002 (Model for Quality Assurance in Design/Development, Production, Installation and Servicing). The intent of this specification requirement is to ensure that the products from the Temperature Control System Manufacturer are delivered through a Quality System and Framework that will assure consistent quality in the products delivered for this project.
4. Product literature provided by the Building Management Control System Manufacturer in the submittal package shall contain the ISO-9002 Certification Mark from the applicable registrar.

#### 1.06 TRAINING

1. All training shall be by the ATC FMCS Contractor / vendor and shall utilize specified manuals, as-built documentation, and the on-line help utility.
2. Operator training shall include eight (8) hours of initial training prior to the completion and close out of the project.
  - Sequence of Operation review.
  - Making adjustments to adjustable (adj) points such as temperature set points, etc.
  - Sign on-Sign off
  - Selection of all displays and reports.
  - Commanding of points, keyboard and mouse mode.
  - Modifying English text.
  - Use of all dialog boxes and menus.
  - Modifying alarm limits and start-stop times.
  - System initialization.
  - Download and initialization of remote controllers.
  - Purge and/or dump of historical data.
  - Troubleshooting of sensors (determining bad sensors).
  - Password modification.

#### 1.07 SUBMITTALS

1. Shop drawings and Product Data: Submit under provisions of General Conditions, shop drawings.
2. Product Data: Catalog sheets, specifications, control/wiring, schematic drawings, installation instructions for each item furnished. Include the valve and damper schedules and communications layout of DDC control system.
3. Shop Drawings:

- A. List of connected data points, including connected control unit and input device.
  - B. System graphics indicating monitored systems, data (connected and calculated) point addresses, and operator notations.
  - C. System configuration with peripheral devices, batteries, power supplies, diagrams, modems and interconnections.
  - D. Descriptive data and sequence of operation of operating, user and application software including Web Browser software/hardware integrations.
  - E. Flow charts showing the logic sequence for each panel. Provide a non-jargon description for each step in the sequence. In addition, identify which variables are built into the system programming, and which have variable names and can be changed by the operator(s) from the Central Processing Unit.
4. Maintenance Data and Operation Instructions: Upon completion of the work and prior to final acceptance, provide copies of “Systems Operation and Maintenance Manuals” for the installed control systems. Manuals shall consist of copies of all temperature control submittals, including schematic diagrams, panel drawings, components parts, Web Browser Networks, accessories, operation and maintenance instructions, recommended spare parts inventory and complete warranty information.
  5. ATC contractor is required to provide a written report stating whether any equipment furnished by ATC contractor is eligible to receive a Program Incentive payment through the NJ Clean Energy Commercial and Industrial Program (New Jersey SmartStart Buildings®), or other NJ Clean Energy/BPU grants or other eligible utility company rebates. The report is to be submitted with original shop drawing submittal. Report shall include all supporting equipment specification sheets, applicable AHRI Certificate and any other documentation required. (Note: a negative report MUST be submitted where applicable). Coordinate with HVAC Equipment which may qualify for Smart Start Incentive for “Controls”.
  6. Provide a Maintenance Service Agreement documenting the responsibilities required in Part 1.07 of this specification.
  7. Delegated design: The ATC Contractor shall be responsible for coordination, sizing, selecting all new and replacement control valves, control dampers and actuators, back draft dampers and actuators, and all other required control devices. Submit all valves, dampers, actuators, etc., for review prior to furnishing and installing.

#### 1.08 SYSTEM DESCRIPTION

1. This specification defines the minimum equipment and performance requirements for a complete Facility Management Control System for the listed buildings HVAC/Mechanical Systems including terminal equipment.

2. It shall be understood that the drawings and specifications describe the approximate locations of the work. Do not scale the drawings to determine exact positions and clearances.
3. Details of construction and of workmanship where not specifically described herein or indicated on the drawings shall be subject to review by the school. It is the intent of these specifications to provide a complete system, left in good working order, ready for operation, including necessary labor and materials, whether specifically shown on the drawings or mentioned herein.
4. Before submitting proposals, examine the specifications and all drawings relating to the work and become fully informed as to the extent and character of the work and the relation of the work to that of other Sections. Examine the drawings of other Buildings Control Systems to become familiar with all the problems and details of the building construction.
5. Automatic temperature control field monitoring and control system using field programmable micro-processor-based units with web browser communications are the intent of this design.
6. Central and remote hardware, software, and interconnecting wire and conduit. User access to new control system shall be from new web browser network.
7. Entire system is to be installed by the ATC Contractor, System Manufacturer or factory authorized representative. Such ATC Contractor shall be one of the three listed in Section 1.05 of this Specification and who is capable of working with and expanding the existing BMS/Control System.
8. The installation shall comply with local, state, and federal code requirements as applicable.
9. This contract also includes the creation of Systems Graphics at the new FMCS/BMS front end computer. The Graphics Programming includes Graphics creation and Dynamic Point editing to reflect all HVAC systems and Hardware System points specified in Part 4.

## **PART 2 PRODUCTS**

### **2.01 DAMPERS**

1. Modulating dampers shall be opposed blade type. Air handling unit outdoor, relief and return air dampers shall be parallel blade type arranged to combat stratification. Two (2) position dampers shall be parallel blade type. Damper frames shall be not less than 13-gauge galvanized steel. Damper blade shall not be over 8" in width and 48" in length.
2. Blade edges shall have inflatable seal edging rated for less than 10 CFM per square foot of damper area. Damper hardware shall be zinc plated; bearings shall be nylon, Teflon, oilite or equal.
3. Damper operators shall be mounted outside of duct on device unless factory installed or internally mounted with access panels.
4. Damper operators shall be mounted outside of duct unless factory installed or internally mounted with access panels. All dampers on equipment exposed in finished spaces shall have internal

mounted operators, increase duct size accordingly.

5. Damper end switches shall sense blade position and not controller output.
6. All dampers and damper motors for outside air intakes for all HVAC equipment shall be spring return, quick - acting type.
7. Power wiring 24V or 110V for all dampers shall be provided by the control contractor. Contractor shall verify location of all dampers requiring power and coordinate all other trades for location of power service. All controls and power wiring shall be coordinate and provided at no additional cost. Provide electrical conduits as required.
8. Electronic Actuators: Provide actuators with spring return for two-position (24v), 0-5 Vdc, 0-10 Vdc, 2-10Vdc, 4-20 mA, or PWM input (subject to restrictions in Section "BAS Field Panels") as required. Actuators shall travel full stroke in less than 90 seconds. Actuators shall be designed for a minimum of 60,000 full cycles at full torque and be UL 873 listed. Provide stroke indicator. Actuators shall have positive positioning circuit. Where two actuators are required in parallel or in sequence provide an auxiliary actuator driver. Actuators shall have current limiting motor protection. Actuators shall have manual override where indicated.
9. Acceptable Manufacturers:
  - a. Belimo
  - b. Schneider Electric
  - c. Siemens
10. Sizing and selection of all dampers, damper actuators, and quantities shall be coordinated by, and provided by the ATC Contractor. Coordinate damper/actuators with all other trades including, mechanical and electrical.

## 2.02 Control Valves

1. General: Provide factory fabricated control valves of type, body material and pressure class indicated. Where type or body material is not indicated, provide selection as determined by manufacturer for installation requirements and pressure class, based on maximum pressure and temperature in piping system. The control valves shall be sized by the ATC Contractor and shall be guaranteed to meet the heating and cooling loads/capacities. ATC Contractor shall be responsible for sizing and selection and providing all control valves and actuators, sized in accordance with industries standards and to minimize pressure drops. Control valves shall be equipped with heavy-duty actuators, stainless steel trim, and with proper close-off rating for each individual application. Minimum close-off rating shall be as scheduled and adequate for each application and shall generally be considered at dead head rating of the pump. Control valves used for the primary chilled and hot water systems shall have a minimum close-off rating of 200 psi unless otherwise required or specified. All valves will be Pressure Independent Flow Control Valves, unless otherwise noted. All valves shall be fully modulating unless noted otherwise. Valves shall be sized for quiet operation, be equipped with throttling plugs, stainless steel trim, renewable composition discs and be capable of operating at varying rates of speed to correspond with the exact dictates of the controller. Install with stem within 50 degrees of vertical position in horizontal pipe.
2. Plug-Type Globe Pattern for Water Service:
  - a. Valve Sizing: Where not specifically indicated on the control drawings, modulating valves shall be sized for maximum full flow pressure drop between 50% and 100% of the branch circuit it is controlling unless scheduled otherwise. Two-position valves shall be same size as connecting piping.
  - b. Temperature Rating: 25°F minimum, 250°F maximum.
  - c. Body: Bronze, screwed, 250 psi maximum working pressure for 1/2" to 2"; Cast Iron, flanged, 125 psi maximum working pressure for 2-1/2" and larger.
  - d. Valve Trim: stainless steel; Stem: Polished stainless steel.
  - e. Packing: Spring Loaded Teflon or Synthetic Elastomer U-cups, self-adjusting.
  - f. Plug: Stainless steel, Seat: Stainless steel.
  - g. Disc: Replaceable Composition or Stainless Steel Filled PTFE.
  - h. Ambient Operating Temperature Limits: -10 to 150°F (-12.2 to 66 °C)
  - i. All control valves will be Pressure Independent Flow Control Valves
3. Acceptable Manufacturers:
  1. Belimo
  2. Flow Control Industries

3. Schneider Electric
4. Siemens

2.03 TEMPERATURE- RH - CO2 SENSORS, AND OTHER SENSORS:

1. Room Temperature Sensor: Shall be an element contained within a ventilated cover suitable for wall mounting. Provide standard white low-profile insulated base. Provide setpoint adjustment and occupancy override where indicated. Provide setpoint adjustment and occupant override where indicated on plans. Provide protective guard in public spaces where indicated.
  - Sensor Type: 10K type 3 thermistor.
  - Accuracy: +/- 0.4°F at calibration point.
  - Output range: 32 to 122°F.
2. Room Relative Humidity Sensor: Shall be an element contained within a ventilated cover suitable for wall mounting. Provide protective guard in public spaces where indicated.
  - Sensor Type: Thin-film capacitive.
  - Output: 0-100% RH.
  - Accuracy: +/- 2% from 10 to 80% RH.
  - Stability: +/- 1% at 68°F annually for 2 years.
3. Room CO2 Sensor: Shall be non-dispersive infrared (NDIR) diffusion sampling type. Provide sensor within a ventilated cover suitable for wall mounting. Provide protective sensor guards in public spaces where indicated.
  - Range: 0 – 2,000 ppm.
  - Accuracy: +/- 30 ppm +/- 2% measured value.
  - Repeatability: +/- 20 ppm +/- 1% measured value
4. Single-Point Duct Temperature Sensor: Shall consist of sensing element, junction box for wiring connections and gasket to prevent air leakage or vibration noise. Temperature range as required for resolution indicated for sensor range above. Sensing element shall be platinum RTD, or thermistor, +/- 0.5°F accuracy at calibration point. Acceptable manufacturer's:
  - Dwyer Instruments
  - Minco
  - Schneider Electric
  - Siemens
5. Averaging Duct Temperature Sensor: Shall consist of an averaging element, junction box for wiring connections and gasket to prevent air leakage. Provide sensor lengths and quantities to result in one lineal foot of sensing element for each four-square feet of cooling coil/duct face area. Temperature range as required for resolution indicated for sensor range above. Averaging sensors shall be provided for mixed air applications and wherever freeze stats are installed. Sensing element shall be platinum RTD, or thermistor, +/- 0.5°F accuracy at calibration point. Acceptable manufacturer's:
  - Dwyer Instruments
  - Minco



- Schneider Electric
  - Siemens
6. Duct / OA CO2 Sensor: Shall be non-dispersive infrared (NDIR) diffusion sampling type.
    - Range: 0 – 2,000 ppm.
    - Accuracy: +/- 40 ppm +/- 3% measured value.
    - Response: 2 min for 99% step change
    - Repeatability: +/- 20 ppm +/- 1% measured value
    - Acceptable manufacturer's: Dwyer, Vaisala, Schneider Electric, Siemens
  7. Duct RH Sensor:
    - Range: 0 - 100% RH.
    - Accuracy: +/- 2% (20 to 95% RH).
    - Repeatability: Less than +/- 0.5%
    - Acceptable manufacturer's: Dwyer, Schneider Electric, Vaisala, Veris
  8. Liquid immersion temperature sensor shall include brass thermowell, sensor and connection head for wiring connections. Temperature range shall be as required for resolution of 0.15°F. Sensing element shall be platinum RTD or thermistor; +/- 0.5°F accuracy at calibration point. Temperature range shall be as required for resolution of 0.15°F. Acceptable manufacturer's:
    - Dwyer Instruments
    - Minco
    - Schneider Electric
    - Veris Industries
  9. Pipe Surface-Mount Temperature Sensor: Shall include metal junction box and clamps and shall be suitable for sensing pipe surface temperature and installation under insulation. Provide thermally conductive paste at pipe contact point. Temperature range shall be as required for resolution indicated in paragraph. Sensing element shall be platinum RTD, thermistor, or integrated circuit, +/- 0.5°F accuracy at calibration point.
  10. Outside air temperature sensors shall consist of a sensor, sun shield, utility box, and watertight gasket to prevent water seepage. Sensing element shall be platinum RTD, +/- 0.5°F accuracy at calibration point. Acceptable Manufacturers:
    - Minco
    - Vaisala
    - Veris Industries
  11. Immersion Temperature Sensors and Thermowells:
    - a. Immersion Temperature sensor shall contain an 20K ohm thermistor to monitor water temperature.
    - b. Thermowells shall be provided by the BMS Contractor (BMSC). The wells shall be of sufficient size for the pipe in which it is to be installed. The sensor and well shall be supplied as a complete assembly, including wellhead and fitting.

- c. Thermowells shall be pressure rated and constructed in accordance with the system working pressure.
  - d. Thermowells and sensors shall be mounted in a threaded or 1/2" NPT saddle and allow easy access to the sensor for repair or replacement.
  - e. Thermowells shall be constructed of 316 stainless steel or as approved by the engineer.
12. Differential Pressure Transmitters
1. differential pressure transmitter shall be of industrial quality and transmit a linear, 4 to 20 mA output in response to variation of differential pressure or air pressure sensing points.
  2. The differential pressure transmitter shall have non-interactive zero and span adjustments that are adjustable from the outside cover and meet the following performance specifications:
    - a. -1.00 to +1.00 w.c. input differential pressure ranges.
    - b. 4-20 mA output.
    - c. Maintain accuracy up to 20 to 1 ratio turndown.
    - d. Reference Accuracy: +0.2% of full span.
  3. Manufacturer:
    - a. Honeywell Controls.
    - b. Varis
    - c. Viasala.
13. Air Filter Status Switches (DPS):
1. Differential pressure switches shall be of the automatic reset type with SPDT contacts rated for 2 amps at 120 VAC.
  2. A complete installation kit shall be provided, including static pressure taps and tubing.
  3. Provide appropriate scale range and differential adjustment for intended service.
  4. Acceptable manufacturers:
    - a. Honeywell Controls.
    - b. Cleveland Controls.
    - c. Engineering approved equal.
14. Air Pressure Safety Switches:
1. Air pressure safety switches shall be of the manual reset type with SPDT contacts rated for 2 amps at 120 VAC.
  2. Pressure range shall be adjustable with appropriate scale range and differential adjustment for intended service.
  3. Acceptable manufacturers
    - a. Honeywell Controls.
    - b. Cleveland Controls.
    - c. Engineering approved equal.
15. Current Switches (CS)
1. Current-operated switches shall be self-powered, solid state with an adjustable trip current.
  2. The switches shall be selected by the BMS Contractor (BMSC) to match the application and output requirements of the DDC system.
  3. The current sensing switch shall be self-powered with solid-state circuitry and a dry contact output.

4. It shall consist of a current transformer, a solid state current sensing circuit, adjustable trip point, solid state switch, SPDT relay, and an LED indicating the on or off status. A conductor of the load shall be passed through the window of the device.
  5. It shall accept over-current up to twice its trip point range.
  6. Approved applications of current sensing switches include monitoring of run status for fans, pumps, and other miscellaneous motor loads.
  7. The Current sensing switches shall be calibrated to show a positive run status only when the motor is operating under load. A motor running with a broken belt or coupling shall indicate a negative run status.
  8. Acceptable manufacturers:
    - a. Honeywell.
    - b. Senva.
    - c. Veris Industries:
16. Smoke and Heat Detectors
1. Smoke and heat detectors shall be furnished and specified elsewhere in Division 26 for installation under Division 23.
  2. All wiring for smoke detectors shall be provided under Division 26, Fire Alarm System.
  3. Equipment and duct smoke detectors shall be shown and alarm status shown on the BMS.
17. System Output Devices
1. Control relays shall provide either momentary or maintained switching action as appropriate for the application. Relay contact configuration, amp, voltage and coil ratings shall be suitable for application.
  2. All panel mounted control relays shall:
    - a. be plugged in type with an interchangeable module (Ice-Cube).
    - b. be mounted on a sub base and wired to numbered terminals strips.
    - c. be DPDT with indicating lamp.
  3. Remotely mounted control relays (outside of the panel) shall be enclosed in a NEMA enclosure suitable for the location. RIB-style relays shall be acceptable for remote control.
  4. All control relays shall be labeled with UR symbol and UL listed.
  5. Acceptable Manufacturers:
    - a. Functional Devices.
    - b. Veris.
    - c. IDEC.

## 2.04 FACILITY MANAGEMENT CONTROL SYSTEM

The Facility Management Control System (FMCS)/Building Management System (BMS) shall be comprised of a network of interoperable, stand-alone digital controllers. The Facility Management Control System shall be comprised of BACnet Ethernet I/P (or BACnet MS/TP in limited locations which may be necessary for integration to mechanical equipment or existing systems). The FMCS shall conform to the following:

1. Controllers shall be dual port BACnet IP with Rapid Spanning Tree (RSTP) communications protocol. The system shall have the capability to identify failure of a single controller without loss of communication to remaining on-line controllers.
2. The system must provide an onsite data collection and storage mechanism to collect and store a BACnet trend log for all points on site including terminal equipment.
  - A. It must be capable of initiating a secure connection to an offsite storage location and must become part of the building's DDC system.
  - B. Management of the onsite system must be available through a local Ethernet connection that provides management of the physical device and its behavior through a local, built-in web server. This web server must allow for configuration, management and monitoring of the device.
  - C. The device(s) must be able to auto-discover all BACnet devices that are connected to it.
  - D. It must identify all trend logs, controller databases and objects.

#### 2.05 BUILDING CONTROLLERS:

1. The Building Controller shall provide the interface between the Building Controller and the field control devices and provide global supervisory control functions over the Mechanical Equipment Controllers, Terminal Equipment Controllers and control devices connected directly to the Building Controller. Controller shall be capable of executing application control programs to provide:
  - Calendar functions
  - Scheduling
  - Trending and Trending Backfill
  - Alarm monitoring and routing
  - Time synchronization
  - Integration of BACnet® devices and BACnet® controller data
  - Integration of MODBUS devices and MODBUS controller data.

#### 2.06 MECHANICAL EQUIPMENT CONTROLLERS:

1. Mechanical Equipment Controllers shall provide high-performance Direct Digital Supervisory Control for all Rooftop AC and Air Handling Units. Communications interface with the Building Controller shall be high speed BACnet Ethernet IP RSTP protocol. The ATC contractor shall be responsible for I/O and safety interface to the mechanical equipment as necessary to meet the specified sequence of operation.

#### 2.07 TERMINAL EQUIPMENT CONTROLLERS:

1. Terminal Equipment Controllers shall provide high-performance Direct Digital Supervisory Control for all VAV Boxes, Fan Coil Units, Unit Ventilators, Duct Heaters and Exhaust Fans. Terminal Equipment controllers shall be provided with dual port BACnet IP RSTP protocol.
2. **For existing unit ventilators, to the greatest extent possible, existing controllers shall be carefully removed from equipment to be removed, inspected and tested, and reinstalled on new/replacement unit ventilators. Provide all new controllers as required to replace damaged and/or malfunctioned controllers.**

#### 2.08 LAN NETWORK HUBS AND MANAGED SWITCHES:

1. Provide managed switches with support for RSTP (Rapid Spanning Tree) protocol.
2. BAS network shall be configured to prevent LAN communications loss in the event of a single controller failure.
3. The RSTP network shall be restricted to BAS controllers with no other third-party devices or switches installed on the network.
4. The BAS shall provide indication of network activity, speed and status.
5. Provide rack mounting hardware and enclosures where necessary.
6. Required 120 Vac power provided by BAS contractor under this section.
7. Approved manufacturers: Cisco.

### **PART 3 EXECUTION**

#### 3.01 ELECTRIC WIRING

1. All power and control wiring in connection with the temperature control system shall be furnished and installed under this contract and shall be per applicable NEC.
2. All electrical controls and switches shall be suitable either for 120 volts, 60 Hz or 24 VAC
3. For control circuits of 115 volts and above, all wire shall be rated for 600 volts and may be either single or multi-conductor cable (refer to series section 26000 specifications for acceptable wiring methods).
4. For control circuits below 30 volts, all wire shall be rated for 300 volts and may be either single or multi-conductor cable.
5. All electrical sensing element wire shall be in accordance with manufacturers' recommendation with the proper number of conductors, equivalent to Beldon No. 8770 and installed in "EMT" conduit in mechanical room. This cable shall not be installed in the same conduit with any conductors for voltages of 115 or above.
6. Electrical work provided shall include, but not limited to:

- A. Wiring from all control devices furnished to the respective equipment being controlled.
  - B. Furnishing and installation of all necessary conduit and wire.
  - C. Interlocking wiring between rooftop units, exhaust fans and radiation as specified in the sequence of operations, shown on the drawings or otherwise required. Interlock between makeup air units and kitchen exhaust hood exhaust fans.
  - D. Installation of smoke detectors and wiring to fan starter unless otherwise specified.
  - E. Wiring of flow switches, sequence relays, thermostats and permissive circuits to boilers.
- 7. Metal raceways shall be installed where pipe cannot be installed in construction and shall be stamped one-piece metal minimum 18-gauge, factory painted color selected and secured to prevent vandalism.
  - 8. In locations where wire cannot be installed above ceiling, wire shall be run in metal raceways or code compliant electrical conduits. Conduits shall be rated for environment in which they are being installed.
  - 9. Except for motor feeders and for existing wiring between motors, motor controllers, feeder panels, fuses, circuits breakers and buss bars. All of the new electrical work required for the facility management control system including but not limited to time switches, damper motors, damper switches, electric thermostats, electric relays, interlocking wiring, wire, conduit, etc.; shall be provided and installed by the FMCS/ATC Contractor. It shall be the FMCS/ATC Contractor's responsibility to provide all wiring required to achieve the functions called for in these specifications.
  - 10. All exposed wiring shall be in EMT or rigid conduit.
  - 11. Control wiring in plenums shall be furnished and installed in EMT or conduit or an approved shielded cable for plenum use above accessible ceiling spaces.

### 3.02 INSTALLATION OF DAMPER MOTORS

- 2. Where damper motors are provided by equipment manufacturer, they shall be completely integrated with the ATC system. The contractor is responsible for all coordination of work not in accordance with above at no extra cost to Owner.

### 3.03 DAMPER AND CONTROL DEVICE LOCATION AND ACCESSIBILITY

- 1. All control equipment requiring service or adjustment located above suspended acoustical ceiling shall have their locations permanently marked on ceiling. Markings shall consist of a color scheme. The markings shall be permanently applied to surface with legend and location agreed to and provided to Owner. Provide in addition to chart, a permanently mounted graphic display as to locations of the devices.
- 2. All devices shall be located to be accessible and easily maintained and if found inaccessible, shall

be relocated by this Contractor at no additional expense to Owner, regardless of the trades involved.

3. Where devices are behind general construction, provide access doors. Coordinate with GC for access doors. All required access doors shall be provided at no additional cost.

### 3.04 ATC PANELS

1. The location and quantity of ATC panels are to be determined and verified in field. Panels to have emergency power electrical connections. The final location and quantity of panels are to be verified with Owner. This Contractor shall be responsible for providing all power wiring and to coordinate all power wiring requirements as to location, quantity, and wire size with electrical contractor. Extension of services, new power wiring for new panels, and all modifications to existing panels which affect electrical contractor shall be the responsibility of the ATC contractor.
2. All ATC panels, controllers, and equipment that require continuous uninterrupted power supply are to remain in operation and shall have battery and/or UPS back-up provided by this Contractor. The back-up shall be for a minimum of 3 hours and shall allow for an orderly shutdown. The resetting, rescheduling, and/or reprogramming of the controls will not be allowed based upon failure to meet the intent of this specification.
3. No unit controllers or ATC panels shall be located above the ceiling.

### 3.05 ACCEPTANCE TESTING

1. Upon completion of the installation, the ATC/FMCS Contractor shall load all system software and start-up the system. This contractor shall perform all necessary calibration, testing and debugging and perform all required operational checks to ensure that the system is functioning in full accordance with these specifications.
2. This Contractor shall perform tests to verify proper performance of components, routines, and points. Repeat tests until proper performance results. This testing shall include a point-by-point log to validate 100% of the input and output points of the DDC system operation.
3. Upon completion of the performance tests described above, repeat these tests, point by point as described in the validation log above in presence of Owner's representative, as required. Properly schedule these tests so testing is complete at a time directed by the Owner's Representative. Do not delay tests so as to prevent delay of occupancy permits or building occupancy.
4. System Acceptance: Satisfactory completion is when this Contractor has performed successfully all the required testing to show performance compliance with the requirements of the Contract Documents to the satisfaction of the Owner's representative. System acceptance shall be contingent upon completion and review of all corrected deficiencies.
5. Commissioning: This Contractor shall complete and provide to the CM and Cx all factory start-up reports and pre-functional documentation. This Contractor shall have the project lead technician attend all Cx meetings. This Contractor shall coordinate with and support the Owners' testing and balancing contractor.

## **PART 4 HARDWARE POINTS**

### 4.01 GENERAL

1. The Facility Management and Control System (FMCS) shall be designed, installed, and commissioned in a fully implemented and operational manner including all installation labor and programming.
2. The below is a generic list and all equipment, points may not be represented. ATC Contractor shall provide all points in point list for ALL equipment on project including points pulled in from unit level controllers provided by packaged RTU manufacturers. Provide all additional required sensors, controls and alarm.

### 4.02 POINTS LIST – Hardwired I/O Points by FMCS.

1. VRF Unit Ventilators (field installed & wired by FMCS/ATC Contractor):
  - UV Supply Fan Start/Stop.
  - UV Supply Fan Low Speed.
  - UV Supply Fan Med Speed.
  - UV Supply Fan HI Speed.
  - Room Exhaust Fan Start/Stop.
  - UV Supply Fan Status.
  - UV Low Temperature Detector.
  - PAC-AH001 / LEV setpoint.
  - PAC-AH001 Cool status.
  - PAC-AH001 Heat status.
  - PAC-AH001 Error.
  - UV SA Temperature.
  - Room Temp / RH.
  - Room CO2.
  - UV OA/RA damper control.
  - UV Hot water coil control valve.
  - BACnet MS/TP integration.

Note: ATC/FMCS Contractor shall coordinate with VRF manufacturer for proper mapping and integration of VRF heat pump/cooling points and controls into the BMS.

2. Existing VAV Boxes served by RTU-1 and RTU-2 and any existing AHUs to remain:
  - Existing Supply airflow
  - Existing Volume damper control.
  - Existing Hot water reheat valve.
  - Existing Space temperature.
  - Discharge air temperature (as available)
  - New Low Temperature Detector (Freeze-stat).
  - BACnet MS/TP integration.
3. Existing Air Handling Units:
  - Supply Fan Start/Stop



- Supply Fan Status
  - Alarm State
  - Mixed Air Temperature
  - Discharge Air Temperature
  - Space Temperature
  - Economizer control
  - Stage 1 Cooling
  - Stage 2 Cooling (where applicable)
  - Reheat control.
  - Return Air Smoke Detector (where applicable)
4. Existing Duct Reheat Coils:
- Hot water valve.
  - Supply air temperature.
  - Space temperature.
  - Low Temperature Detector (Freeze-stat).
5. Classroom Exhaust Fans/Gravity Relief Air Ventilators:
- Exhaust fan Start/Stop.
  - Automatic Damper Operation (where applicable)
  - Room/Building differential pressure control (ATC provided sensors)
  - Fan speed.
6. Toilet Exhaust Fans:
- Exhaust fan Start/Stop.
  - Automatic Damper Operation (where applicable)
8. Packaged Rooftop Units
- Outside Air Temp
  - Outside Air RH
  - Return air smoke detector
  - Return air CO2
  - Return air Temp
  - Return air RH
  - Building Differential Pressure
  - Power Exhaust Start/Stop
  - Power Exhaust Speed
  - Return Air Damper Position
  - Outside Air Damper
  - Mixed Air Temperature
  - Dirty Filter Switches
  - Cooling Modes/Stages
  - Hot-gas reheat
  - Natural Gas Heating Mode
  - Natural Gas Mod/Stages
  - Discharge Air Temperature
  - Room Temp
  - Room RH

- Room Set Points Adj
- Room CO2

**PART 5A SPACE SETPOINTS**

	SPACE SETPOINT
Occupied Heating	72°F.
Morning Warm-up	72°F.
Unoccupied Heating	60°F.
Occupied Cooling	74°F.
Cool-down	74°F.
Unoccupied Cooling	80°F.
Relative Humidity	55% RH

Note: All setpoints to be adjustable by Owner via FMCS.

**OCCUPIED/UNOCCUPIED PERIODS**

The purpose of this schedule is to establish a baseline for equipment operation and sequencing. This is to allow systems to provide optimum effectiveness and increase efficiency. The hours of operation shall be reviewed with the school prior to occupancy. The contractor shall provide as part of their training, instructions to Owner for changing and adjusting times of operation. The hours of operation shall also be adjustable for individual equipment and / or zones (i.e., Gymnasium, Auditorium).

**Occupied Heating 6AM**

Optimal start-up with adjustment based on system requirements.

**Unoccupied Heating 3PM** (Schedule for after school usage shall be adjustable for this period).

**Occupied Cooling 7AM** (Optimal smart start-up with adjustment based on system requirements).

**Unoccupied Cooling 3PM** (Schedule for after school usage shall adjust this period).  
 of operations shall match existing units operation except as specified.

END OF SECTION 230900